

MISSISSIPPI DEPARTMENT OF NATURAL RESOURCES

Bureau of Land and Water Resources

Southport Mall

P.O. Box 10631

Jackson, Mississippi 39209

WATER WELL DRILLERS LOG

<u>Pike</u>
<u>200</u>
<u>J 106</u>

W.F.F.

✓

2/17 1987 date well completed

87 Tom Griffith well Ser firm name

Pike county well located

LANDOWNER: David New

description of formations encountered

from

to

PO Box 1487

Natchez, Ms 39120
(mailing address)

Clay	1	15
Sand	15	70
Big Gravel	70	300

WELL LOCATION:

sec. 28 T. 3 N. R. 8 E.
3 miles SE of M^o COMB
(distance) (direction) (nearest town)

MIN² - W. 1/4 sec 28 N. 3 T. 3 E. R. 8 E.

WELL PURPOSE: Oil Rig
(home, irrigation, municipal, industrial)

WELL COMPLETION DATA:

- (1) diameter (inches) 3 1/2
- (2) total depth (feet) 300'
- (3) static water level (feet) 110 below above top of ground.

450' S and 330' W of NE corner SE SW

- (4) casing PVC, 280,
(material) (depth)

3"
(size) if telescope see back.

- (5) screen 20, 280
(length) (depth to top)

3", PVC
(size) (material)

- (6) pump air lift, 80
(HP) (yield gpm)

diesel
(type power)

- (7) electric log NO
(yes or no)

NA
(organization running log)

- (8) how well bottom plugged BWC

RECEIVED


SEP 24 1987

Department of Natural Resources
Bureau of Land & Water Resources

DRILLERS REMARKS:

If well telescopes please sketch and show depths.

GROUND LEVEL

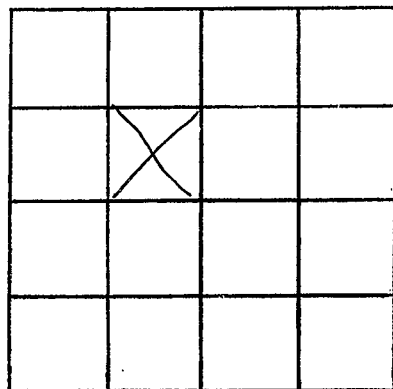

SECTION 28

Please indicate well location X.

ADDITIONAL INFORMATION

If more than one screen,
show locations of each on sketch.