

PIKE
J 107
4-7-79

**MISSISSIPPI
BOARD OF WATER COMMISSIONERS**
416 North State Street
Jackson, Mississippi 39201

CODED

WATER WELL DRILLERS LOG

April 7 19 79 Runumilla Pike
 (date well completed) (firm name) (county well located)

LANDOWNER:	description of formations encountered	from	to
(mailing address)			
<u>Lark Hammon</u>	<u>Chalk</u>	<u>0</u>	<u>16</u>
<u>Pt 1 McComb</u>	<u>Sand & gravel</u>	<u>16</u>	<u>37</u>
	<u>Chalk & shell</u>	<u>37</u>	<u>104</u>
	<u>pink chalk</u>	<u>104</u>	<u>120</u>
	<u>fine gravel & sand</u>	<u>120</u>	<u>160</u>
WELL LOCATION:			
sec. <u>10</u> T. <u>2</u> N. R. <u>9</u> E.			
<u>11</u> miles <u>E. SE</u> of <u>McComb</u>			
(distance) (direction) (nearest town)			
WELL PURPOSE: <u>Carry</u> (home, irrigation, municipal, industrial)			
WELL COMPLETION DATA:			
(1) diameter (inches) <u>4"</u>			
(2) total depth (feet) <u>160</u>			
(3) static water level (feet) <u>below top of ground</u>			
(4) casing <u>plastic bottom</u> (material) (depth)			
<u>if telescope see back.</u> (size)			
(5) screen <u>10</u> <u>150'</u> (length) (depth to top)			
<u>4"</u> <u>plastic</u> (size) (material)			
(6) pump <u>flow</u> <u>60</u> (HP) (yield gpm)			
<u>no power</u> (type power)			
(7) electric log <u>no</u> (yes or no)			
(organization running log)			
(8) how well bottom plugged <u>no order plug</u>			
DRILLERS REMARKS:			

CODED


Miss. Board of Water Comm.

AUG 24 1979

RECEIVED

If well telescopes please
sketch and show depths.

GROUND LEVEL

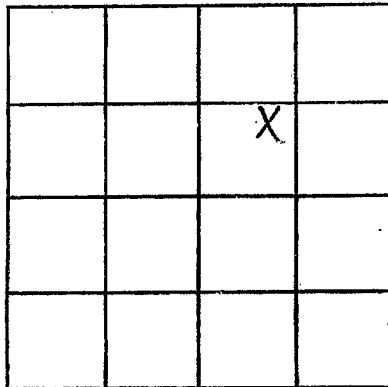

SECTION 11

Please indicate well location X.

ADDITIONAL INFORMATION

If more than one screen,
show locations of each on sketch.