

Pike  
J 2000 1  
12-1-75

**MISSISSIPPI  
BOARD OF WATER COMMISSIONERS**  
416 North State Street  
Jackson, Mississippi 39201


**WATER WELL DRILLERS LOG**

12-1 19 75 Fitzgerald Well Serv Pike  
date well completed      firm name      county well located

LANDOWNER:	description of formations encountered	from	to
<u>Wilma Timm</u> <u>R.R. Telectron</u> (mailing address)			
<b>WELL LOCATION:</b>			
sec. <u>35</u> T <u>2</u> N <u>R</u> <u>9</u> E <u>S</u> <u>E</u>			
<u>10</u> miles <u>W</u> of <u>Telectron</u> (distance) (direction) (nearest town)			
<b>WELL PURPOSE:</b> <u>Home</u> (home, irrigation, municipal, industrial)			
<b>WELL COMPLETION DATA:</b>			
(1) diameter (inches) <u>4</u>			
(2) total depth (feet) <u>108</u>			
(3) static water level (feet) <u>50</u> below top of ground. above			
(4) casing <u>PVC</u> <u>100</u> (material) (depth)			
<u>4</u> (size) if telescope see back.			
(5) screen <u>8</u> <u>100</u> (length) (depth to top)			
<u>4</u> <u>PVC</u> (size) (material)			
(6) pump <u>1/2</u> <u>10</u> (HP) (yield gpm)			
<u>elec</u> (type power)			
(7) electric log <u>no</u> (yes or no)			
(organization running log)			
(8) how well bottom plugged <u>Sand Blank</u>			
<b>DRILLERS REMARKS:</b>			
DEC 17 1975			
BO. OF WATER COMMISSIONERS			

If well telescopes please sketch and show depths.

GROUND LEVEL

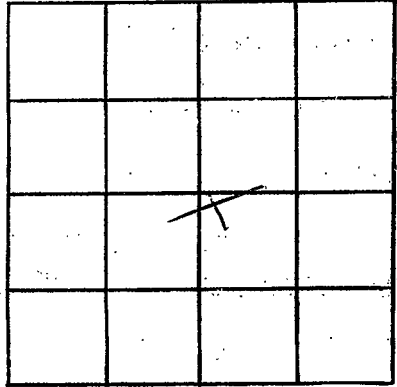

SECTION 35

Please indicate well location X.

ADDITIONAL INFORMATION

If more than one screen, show locations of each on sketch.