

Pike
 J 2002
 9-19-75

MISSISSIPPI
 BOARD OF WATER COMMISSIONERS
 416 North State Street
 Jackson, Mississippi 39201

WATER WELL DRILLERS LOG

Sept 19 1975 *Reuma Well Sec* *Pike*
 date well completed firm name county well located

LANDOWNER:
Robert Williams
At 2 Magnolia
 (mailing address)

description of formations encountered	from	to
<i>Red Clay</i>	<i>0</i>	<i>22</i>
<i>clay gravel</i>	<i>22</i>	<i>35</i>
<i>chert</i>	<i>35</i>	<i>80</i>
<i>limestone</i>	<i>80</i>	<i>120</i>
<i>pyrite sand</i>	<i>120</i>	<i>139</i>

WELL LOCATION:
 sec. *9* T. *2* N. R. *9* E
4 miles *South* of *Homesville*
 (distance) (direction) (nearest town)

WELL PURPOSE: *home*
 (home, irrigation, municipal, industrial)

- WELL COMPLETION DATA:
- (1) diameter (inches) *4"*
 - (2) total depth (feet) *139*
 - (3) static water level (feet) *85* below top of ground.
 - (4) casing *plate, bottom* (material) (depth)
 - (size) if telescope see back.
 - (5) screen *6"* *133* (length) (depth, to top)
 - 4"* *plate* (size) (material)
 - (6) pump *1/2* *10* (HP) (yield gpm)
 - elect* (type power)
 - (7) electric log *no* (yes or no)
 - (organization running log)
 - (8) how well bottom plugged


DEPT. OF WATER
 JAN 2 1976

DRILLERS REMARKS:
Woodsbury
get home

MISS. BD. OF WATER COMMISSIONERS

If well telescopes please sketch and show depths.

GROUND LEVEL

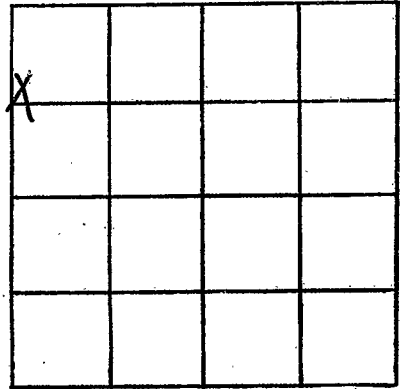

SECTION 9

Please indicate well location X.

ADDITIONAL INFORMATION

If more than one screen, show locations of each on sketch.