

Pike
 J 2003
 8-27-75

MISSISSIPPI
 BOARD OF WATER COMMISSIONERS
 416 North State Street
 Jackson, Mississippi 39201

WATER WELL DRILLERS LOG

Aug 27 1975 Remmell Drilling Pike
 date well completed firm name county well located

LANDOWNER:
John Miller
At. Macondia
 (mailing address)


description of formations encountered	from	to
<u>Red Clay</u>	<u>0</u>	<u>19</u>
<u>Clay with sand</u>	<u>19</u>	<u>30</u>
<u>Shells</u>	<u>30</u>	<u>55</u>
<u>sand & gravel</u>	<u>55</u>	<u>80</u>
<u>Red Chalk</u>	<u>80</u>	<u>103</u>
<u>coarse sand & gravel</u>	<u>103</u>	<u>130</u>

WELL LOCATION:
 sec. 29 T. 2 N. R. 9 E.
4 1/2 miles N. of Progress
 (distance) (direction) (nearest town)

WELL PURPOSE: Home
 (home, irrigation, municipal, industrial)

- WELL COMPLETION DATA:
- (1) diameter (inches) 4"
 - (2) total depth (feet) 130
 - (3) static water level (feet) 70 below top of ground.
 - (4) casing plastic (material) bottom (depth)
 - (5) screen 6" (size) 124' (length) 124' (depth to top)
 - (6) pump Sub (HP) 10 (yield gpm)
 - (7) electric log no (yes or no)
 - (8) how well bottom plugged: wooden plug


DRILLERS REMARKS:
old plastic well casing collapse

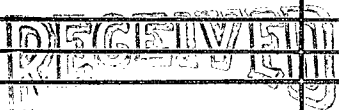

JAN 2 1976

If well telescopes please sketch and show depths.

GROUND LEVEL

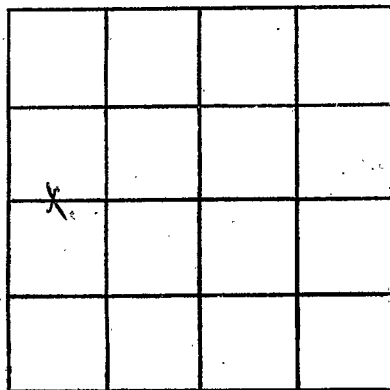

SECTION 29

Please indicate well location X.

ADDITIONAL INFORMATION

If more than one screen,
show locations of each on sketch.