

Pike
J 2004
12/8/76

MISSISSIPPI
 BOARD OF WATER COMMISSIONERS
 416 North State Street
 Jackson, Mississippi 39201

WATER WELL DRILLERS LOG

12-8 date well completed 1976 Fitzgerald Well Service firm name Pike county well located

LANDOWNER: Lethel Williams
R.R. Magnolia, Miss
 (mailing address)
 WELL LOCATION:
 sec. 4 T. 2 N. R. 9 E
S W
8 miles SE of M'Comb
 (distance) (direction) (nearest town)

description of formations encountered	depth	
	from	to
<u>Red clay</u>	<u>0</u>	<u>20</u>
<u>Red sand</u>	<u>20</u>	<u>90</u>
<u>Red gravel</u>	<u>90</u>	<u>105</u>
<u>Coarse sandstone</u>	<u>105</u>	<u>130</u>

WELL PURPOSE: Home
 (home, irrigation, municipal, industrial)

WELL COMPLETION DATA:
 (1) diameter (inches) 4
 (2) total depth (feet) 130
 (3) static water level (feet) 105 below above top of ground.
 (4) casing PVC, 122,
 (material) (depth)
4 If telescope see back.
 (size)
 (5) screen 8, 122
 (length) (depth to top)
4, PVC
 (size) (material)
 (6) pump 1/2, 20
 (HP) (yield gpm)
Electric
 (type power)
 (7) electric log no
 (yes or no)
 (organization running log)
 (8) how well bottom plugged sealed


DRILLERS REMARKS:

RECEIVED
 DEC 23 1976

MISS. BD. OF WATER COMMISSIONERS

If well telescopes please sketch and show depths.

GROUND LEVEL

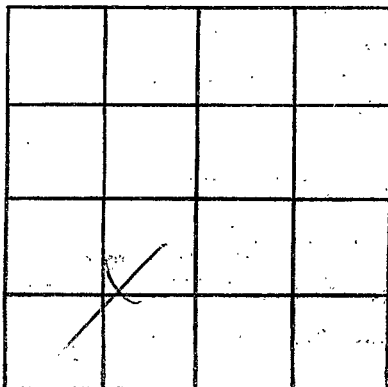

SECTION 4

Please indicate well location X.

ADDITIONAL INFORMATION

If more than one screen,
show locations of each on sketch.