

Pike
 J 2005
 10/12/76

MISSISSIPPI
 BOARD OF WATER COMMISSIONERS
 416 North State Street
 Jackson, Mississippi 39201

1381

WATER WELL DRILLERS LOG

Oct 12 1976 date well completed
 The Remus Miller firm name
 Pipe county well located

LANDOWNER:	description of formations encountered	from	to
Sydney Water Mining			
At 3 Magnolia (mailing address)	Sand & Gravel	20	50
	Shells	50	90
	Gravelly sand	90	115

WELL LOCATION:
 sec. 8 T 2 N R 9 E
 7 1/2 miles east of Magnolia
 (distance) (direction) (nearest town)

WELL PURPOSE: home
 (home, irrigation, municipal, industrial)

- WELL COMPLETION DATA:
- (1) diameter (inches) 4"
 - (2) total depth (feet) 115
 - (3) static water level (feet) 55 below top of ground.
 - (4) casing plastic bottom (material) (depth)
 - (size) if telescope see back.
 - (5) screen 6' 109 (length) (depth to top)
 - 4" plastic (size) (material)
 - (6) pump 1/2 sub 1.0 (HP) (yield gpm)
 - split (type power)
 - (7) electric log no (yes or no)
 - (organization running log)

(8) how well bottom plugged
 wooden plug


DRILLERS REMARKS:
 new house

RECEIVED
 DEC 8 1976

MISS. BD. OF WATER COMMISSIONERS

If well telescopes please sketch and show depths.

GROUND LEVEL

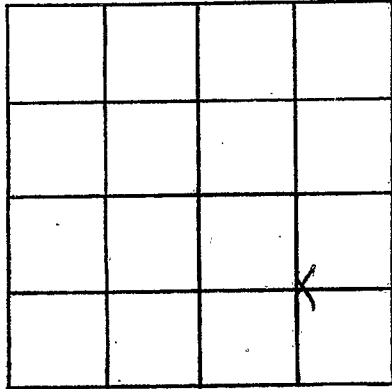

SECTION 8

Please indicate well location X.

ADDITIONAL INFORMATION

If more than one screen, show locations of each on sketch.