

Pike
J 2007
7/28/76

MISSISSIPPI
 BOARD OF WATER COMMISSIONERS
 416 North State Street
 Jackson, Mississippi 39201

WATER WELL DRILLERS LOG

July 28 1976 Reaves Well Dr. Pike
 date well completed firm name county well located

LANDOWNER:
Vester Thompson
Rt 2 - M. E. Cook -
 (mailing address)

description of formations encountered	from	to
<u>Clay ground</u>	<u>0</u>	<u>28</u>
<u>Red sand gravel</u>	<u>28</u>	<u>96</u>
<u>White Chalk</u>	<u>96</u>	<u>138</u>
<u>Coarse sand</u>	<u>138</u>	<u>162</u>

WELL LOCATION:
 sec. 4 T 2 N R 9 E
4 miles South of Holmes
 (distance) (direction) (nearest town)

WELL PURPOSE: new house
 (home, irrigation, municipal, industrial)

WELL COMPLETION DATA:

(1) diameter (inches) 4"

(2) total depth (feet) 162

(3) static water level (feet) 100 below/above top of ground.

(4) casing plastic (material) bottom (depth)
 (size) If telescope see back.

(5) screen 6' (length) 156 (depth to top)
4" (size) plastic (material)

(6) pump leather (HP) (yield gpm)
elct (type power)

(7) electric log no (yes or no)
 (organization running log)

(8) how well bottom plugged
Washed by

DRILLERS REMARKS:


RECEIVED

OCT 26 1976

MISS. BD. OF WATER COMMISSIONERS

If well telescopes please sketch and show depths.

GROUND LEVEL

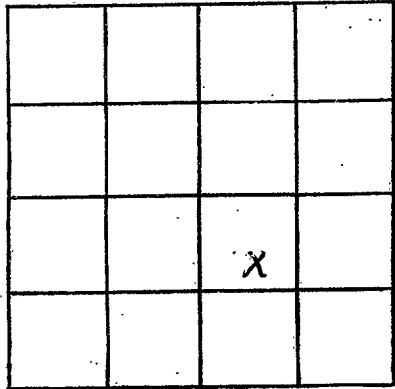

SECTION 4

Please indicate well location X.

ADDITIONAL INFORMATION

If more than one screen,
show locations of each on sketch.