

Pike
J 2011
4-15-76

MISSISSIPPI
 BOARD OF WATER COMMISSIONERS
 416 North State Street
 Jackson, Mississippi 39201

WATER WELL DRILLERS LOG

4-15 date well completed 1976 Fitzgould Well Serv firm name Pike county well located

LANDOWNER:	description of formations encountered	from	to
<u>Wallace McKenzies</u>			
<u>R.R. McComb Min.</u> (mailing address)	<u>red clay</u>	<u>0</u>	<u>20</u>
	<u>red gravel</u>	<u>20</u>	<u>80</u>
	<u>Coarse Sand & gravel</u>	<u>80</u>	<u>95</u>

LANDOWNER:

description of formations encountered

from

to

WELL LOCATION:

sec. 27 T-2(N) R-9(E)

19 miles SE of McComb
 (distance) (direction) (nearest town)

WELL PURPOSE: Home
 (home, irrigation, municipal, industrial)

WELL COMPLETION DATA:

- (1) diameter (inches) 4
- (2) total depth (feet) 95
- (3) static water level (feet) 55 below top of ground.

(4) casing PVC 87
 (material) (depth)
4 If telescope see back.
 (size)

(5) screen PVC 87
 (length) (depth to top)

4 PVC
 (size) (material)

(6) pump 1 20
 (HP) (yield gpm)

gas
 (type power)

(7) electric log no
 (yes or no)

(organization running log)


(8) how well bottom plugged solid

DRILLERS REMARKS:

JUL 1 1976
 MISSISSIPPI BOARD OF WATER COMMISSIONERS

If well telescopes please sketch and show depths.

GROUND LEVEL

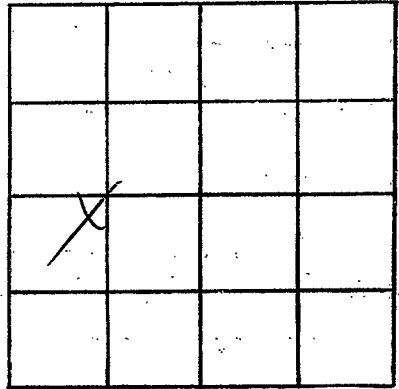

SECTION 27

Please indicate well location X.

ADDITIONAL INFORMATION

If more than one screen, show locations of each on sketch.