

Pike
 J 2014
 12/19/77

MISSISSIPPI
 BOARD OF WATER COMMISSIONERS
 416 North State Street
 Jackson, Mississippi 39201

WATER WELL DRILLERS LOG

12-19-77 date well completed 27 Fitzgerald Well Dr firm name Pike county well located

LANDOWNER:
 A. Conroy
 R.R. McGee
 (mailing address)

WELL LOCATION:
 sec. 3 T. 2 N. R. 9 E
 11 miles E of McGee
 (distance) (direction) (nearest town)

WELL PURPOSE: Home
 (home, irrigation, municipal, industrial)

- WELL COMPLETION DATA:
- (1) diameter (inches) 4
 - (2) total depth (feet) 170
 - (3) static water level (feet) 100 below top of ground.
 - (4) casing (material) PVC (depth) 162
 4 If telescope see back. (size)
 - (5) screen 8 (length) 162 (depth to top)
 4 (size) PVC (material)
 - (6) pump 1/2 (HP) 10 (yield. gpm)
 4 (type power)
 - (7) electric log No (yes or/no)
 (organization running log)
 - (8) how well bottom plugged Sand fill


description of formations encountered	from	to
Red Clay	0	20
Red Shale	20	65
White Chalk	65	160
Green Sand & Gravel	160	170

DRILLERS REMARKS:

RECEIVED
 DEC 28 1977
 MISS. Bd. OF WATER COMMISSIONERS

If well telescopes please sketch and show depths.

GROUND LEVEL

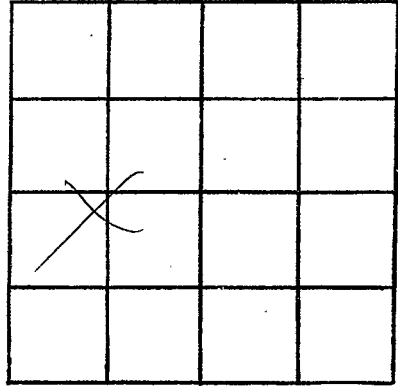

SECTION 3

Please indicate well location X.

ADDITIONAL INFORMATION

If more than one screen,
show locations of each on sketch.