

PIKE
J 2014
9/29/77

MISSISSIPPI
BOARD OF WATER COMMISSIONERS
416 North State Street
Jackson, Mississippi 39201

133

WATER WELL DRILLERS LOG

9-29 1977 *Reeves Wellser* *Pike*
date well completed firm name county well located

LANDOWNER:
James Barnes
Rt 2 McComb
(mailing address)

description of formations encountered	from	to
<i>Red Clay</i>	<i>0</i>	<i>27</i>
<i>Red sand</i>	<i>27</i>	<i>65</i>
<i>hard gravel</i>	<i>65</i>	<i>80</i>
<i>hollow</i>	<i>80</i>	<i>95</i>
<i>gravel sand</i>	<i>95</i>	<i>118</i>

WELL LOCATION:
sec. *18* T-*2* N R-*9* E
7 miles *east* of *Magnolia*
(distance) (direction) (nearest town)

WELL PURPOSE: *Home*
(home, irrigation, municipal, industrial)

- WELL COMPLETION DATA:
- (1) diameter (inches) *4"*
 - (2) total depth (feet) *118*
 - (3) static water level (feet) *90* below top of ground *above*
 - (4) casing *plastic bottom*
(material) (depth)
(size) If telescope see back.
 - (5) screen *5'* *113'*
(length) (depth to top)
4" *plastic*
(size) (material)
 - (6) pump *1/2* *10*
(HP) (yield gpm)
elect
(type power)
 - (7) electric log *no*
(yes or no)
- (organization running log)


(8) how well bottom plugged
wooden plug

DRILLERS REMARKS:
L

RECEIVED
FEB 27 1978

If well telescopes please sketch and show depths.

GROUND LEVEL

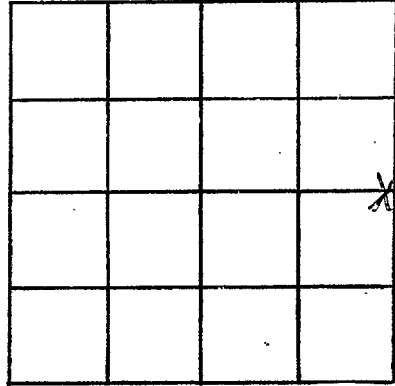

SECTION 18

Please indicate well location X.

ADDITIONAL INFORMATION

If more than one screen,
show locations of each on sketch.