

PIKE
 J 2057
 9/16/77

MISSISSIPPI
 BOARD OF WATER COMMISSIONERS
 416 North State Street
 Jackson, Mississippi 39201

125

WATER WELL DRILLERS LOG

9-16 1977 *Remus well ser.* *Pike*
 date well completed firm name county well located

LANDOWNER:
Kenneth Smith
Rt 3 Magnolia
 (mailing address)

description of formations encountered	from to	
<i>red clay</i>	<i>2</i>	<i>20</i>
<i>red sand & gravel</i>	<i>20</i>	<i>80</i>
<i>lumpy</i>	<i>80</i>	<i>105</i>
<i>sand & gravel</i>	<i>105</i>	<i>135</i>

WELL LOCATION:
 sec. *29* T-*2* N R-*9* E
10 miles *E-SE* of *Magnolia*
 (distance) (direction) (nearest town)

WELL PURPOSE: *home*
 (home, irrigation, municipal, industrial)


- WELL COMPLETION DATA:
- (1) diameter (inches) *4 1/2"*
 - (2) total depth (feet) *135*
 - (3) static water level (feet) *90* below above top of ground.
 - (4) casing *plastic bottom*
 (material) (depth)
 if telescope see back.
 (size)
 - (5) screen *3'*, *130*
 (length) (depth to top)
4", *plastic*
 (size) (material)
 - (6) pump *1/2 sub*, *10*
 (HP) (yield gpm)
slut
 (type power)
 - (7) electric log *no*
 (yes or no)
- (organization running log)

(8) how well bottom plugged
wooden plug
 DRILLERS REMARKS:

RECEIVED
 FEB 21 1978

If well telescopes please sketch and show depths.

GROUND LEVEL

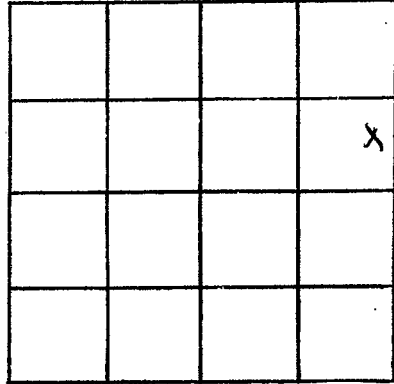

SECTION 29

Please indicate well location X.

ADDITIONAL INFORMATION

If more than one screen, show locations of each on sketch.