

Pike
 J 209
 6-9-77

MISSISSIPPI
 BOARD OF WATER COMMISSIONERS
 416 North State Street
 136 Jackson, Mississippi 39201

58

WATER WELL DRILLERS LOG

June 6 1977 Rees Miller Pike
 date well completed firm name county well located

LANDOWNER:
 Joseph Davis
 Rt Magnolia
 (mailing address)

description of formations encountered	from	to
Red Clay	0	20
Red Sand	20	70
Chalky sand & gravel	70	120
Sandy pebbles & gravel	120	134

WELL LOCATION:
 sec. 26 T 20 N R 9 E ?
 S W
 11 miles E-SE of Magnolia
 (distance) (direction) (nearest town)

WELL PURPOSE: Home
 (home, irrigation, municipal, industrial)

WELL COMPLETION DATA:

(1) diameter (inches) 4 1/2"

(2) total depth (feet) 134'

(3) static water level (feet) 125' below above top of ground

(4) casing plastic bottom
 (material) (depth)

(size) if telescope see back.

(5) screen 5" 129'
 (length) (depth to top)

4" plastic
 (size) (material)

(6) pump beaters
 (HP) (yield gpm)

elect
 (type power)

(7) electric log ne
 (yes or no)

(organization running log)


(8) how well bottom plugged
 wooden plug

DRILLERS REMARKS:

RECEIVED
 AUG 26 1977

If well telescopes please sketch and show depths.

GROUND LEVEL

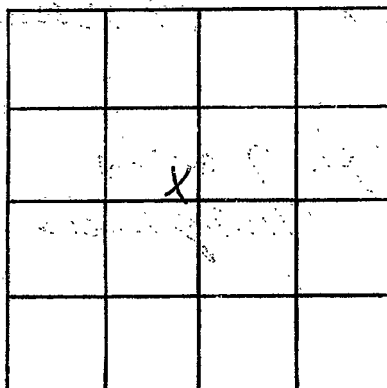

SECTION 26

Please indicate well location X.

ADDITIONAL INFORMATION

If more than one screen, show locations of each on sketch.