

Pike
 J 2020
 5-26-77

MISSISSIPPI
 BOARD OF WATER COMMISSIONERS
 416 North State Street
 144 Jackson, Mississippi 39201

(51)

WATER WELL DRILLERS LOG

May 26 1977 Pecos Well Co Pike
 date well completed firm name county well located

LANDOWNER:
Mr. Paul Hamley
Rt 1 Magnolia
 (mailing address)

description of formations encountered	from	to
Red Clay	0	22
Red sand	22	60
Sand & gravel	60	100
Pink shell	100	115
Hard gravel	115	126
Sand	-	-

WELL LOCATION:
 sec. 31 T. 2 N R. 9 E
7 miles S-SE of Magnolia
 (distance) (direction) (nearest town)

WELL PURPOSE: Trailer
 (home, irrigation, municipal, industrial)

WELL COMPLETION DATA:
 (1) diameter (inches) 4"
 (2) total depth (feet) 126
 (3) static water level (feet) 106 below top of ground.
 (4) casing plastic bottom
 (material) (depth)
 If telescope see back.
 (size)
 (5) screen 5' 121
 (length) (depth to top)
4" plastic
 (size) (material)
 (6) pump 1/2 10
 (HP) (yield gpm)
elect
 (type power)
 (7) electric log no
 (yes or no)
 (organization running log)

(8) how well bottom plugged:
Wooden plug


DRILLERS REMARKS:

RECEIVED
 JUN 21 1977

MISS. Bd. OF WATER COMMISSIONERS

If well telescopes please sketch and show depths.

GROUND LEVEL

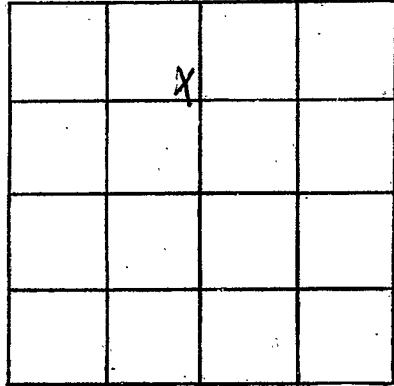

SECTION 31

Please indicate well location X.

ADDITIONAL INFORMATION

If more than one screen, show locations of each on sketch.