

Pike
J 2021
4/25/77

MISSISSIPPI
 BOARD OF WATER COMMISSIONERS
 416 North State Street
 137A Jackson, Mississippi 39201

(36)

WATER WELL DRILLERS LOG

April 25 1977 Reynolds Pike
 date well completed firm name county well located

LANDOWNER:
Mr. Wren Bullock
Rt 2 McComb
 (mailing address)

description of formations encountered	from	to
<u>Red sandy clay</u>	<u>0</u>	<u>18</u>
<u>Red chert sand</u>	<u>18</u>	<u>115</u>
<u>Sand & gravel</u>	<u>115</u>	<u>140</u>

WELL LOCATION:
 sec. 8 T. 2 N R. 9 E
8 1/2 miles east of Magnolia
 (distance) (direction) (nearest town)

WELL PURPOSE: home
 (home, irrigation, municipal, industrial)

- WELL COMPLETION DATA:
- (1) diameter (inches) 4"
 - (2) total depth (feet) 140
 - (3) static water level (feet) 100 above top of ground.
 - (4) casing plastic bottom
 (material) (depth)
1/2 if telescope see back.
 (size)
 - (5) screen 6" 136'
 (length) (depth to top)
4" plastic
 (size) (material)
 - (6) pump 1/2 10
 (HP) (yield gpm)
split
 (type power)
 - (7) electric log no
 (yes or no)
no
 (organization running log)


(8) how well bottom plugged
wooden plug

DRILLERS REMARKS:
old well Rusty

RECEIVED
 APR 24 1977
 MISS. BD. OF WATER COMM.

If well telescopes please sketch and show depths.

GROUND LEVEL

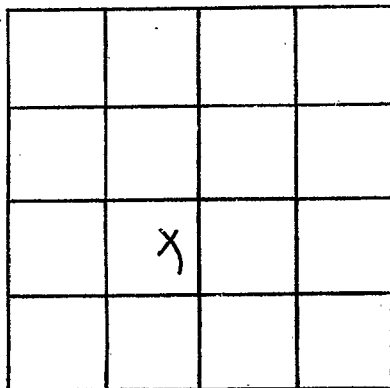

SECTION 8

Please indicate well location X.

ADDITIONAL INFORMATION

If more than one screen, show locations of each on sketch.