

Pike
 J 2022
 4/22/77

MISSISSIPPI
 BOARD OF WATER COMMISSIONERS
 416 North State Street
 132 Jackson, Mississippi 39201

25

WATER WELL DRILLERS LOG

April 22 1977 Rever Well Co Pike
 date well completed firm name county well located

LANDOWNER:
Earnest M. Cannon
Rt 2 McComb
 (mailing address)

description of formations encountered	from	to
<u>Red Clay</u>	<u>0</u>	<u>20</u>
<u>sand & gravel</u>	<u>20</u>	<u>45</u>
<u>gray chalk</u>	<u>45</u>	<u>105</u>
<u>bedrock & gravel</u>	<u>105</u>	<u>114</u>

WELL LOCATION:
 sec. 5 T-2 N R-9 E
8 miles east of McComb
 (distance) (direction) (nearest town)

WELL PURPOSE: home
 (home, irrigation, municipal, industrial)

WELL COMPLETION DATA:
 (1) diameter (inches) 4"
 (2) total depth (feet) 114
 (3) static water level (feet) 85 below above top of ground.
 (4) casing plastic bottom (material) (depth)
 (size) if telescope see back.
 (5) screen 6" 108' (length) (depth to top)
4" plastic (size) (material)
 (6) pump 1/2 10 (HP) (yield gpm)
elect (type power)
 (7) electric log no (yes or no)
 (organization running log)


(8) how well bottom plugged
wooden plug
 DRILLERS REMARKS:

RECEIVED
 AUG 4 1977

MISS. BD. OF WATER COMMISSIONERS

If well telescopes please sketch and show depths.

GROUND LEVEL

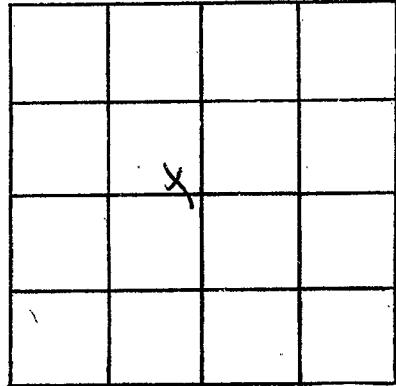

SECTION 5

Please indicate well location X.

ADDITIONAL INFORMATION

If more than one screen, show locations of each on sketch.