

Pike
J 2023
4-19-77

MISSISSIPPI
BOARD OF WATER COMMISSIONERS
416 North State Street
132A Jackson, Mississippi 39201

WATER WELL DRILLERS LOG

4-19 1977 Fitzgerald well Serv Pike
date well completed firm name county well located

LANDOWNER: Hugh Tate
R.R. McComb
(mailing address)


description of formations encountered	from	to
<u>Red Clay</u>	<u>0</u>	<u>92</u>
<u>Blue Clay</u>	<u>22</u>	<u>175</u>
<u>Coarse sand & gravel</u>	<u>175</u>	<u>186</u>

WELL LOCATION:
sec. 10 T. 2 N. R. 9 E.
S. W.
8 miles E of McComb
(distance) (direction) (nearest town)

WELL PURPOSE: Home
(home, irrigation, municipal, industrial)

- WELL COMPLETION DATA:
- (1) diameter (inches) 4
 - (2) total depth (feet) 186
 - (3) static water level (feet) 12 below above top of ground.
 - (4) casing PVC, 178,
(material) (depth)
4 if telescope see back.
(size)
 - (5) screen 8, 178,
(length) (depth to top)
4, PVC
(size) (material)
 - (6) pump 1/2, 10,
(HP) (yield gpm)
Electric
(type power)
 - (7) electric log no
(yes or no)
(organization running log)
 - (8) how well bottom plugged Small blk


DRILLERS REMARKS:

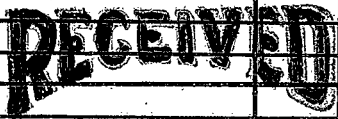

MAR 5 1977

If well telescopes please sketch and show depths.

GROUND LEVEL

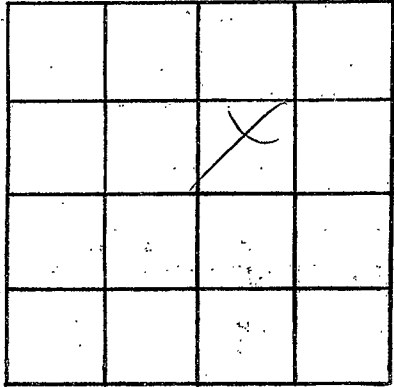

SECTION 10

Please indicate well location 'X'.

ADDITIONAL INFORMATION

Lined area for additional information.

If more than one screen, show locations of each on sketch.