

Pike
 J 2024
 2/14/77

MISSISSIPPI
 BOARD OF WATER COMMISSIONERS
 416 North State Street
 Jackson, Mississippi 39201

13

WATER WELL DRILLERS LOG

Feb. 14 1977 Reuss Well Dr. Pike
 date well completed firm name county well located

LANDOWNER:
 Gessie Hall
 Rt. Magnolia
 (mailing address)

description of formations encountered	from	to
Red Clay	0	27
Red sand	27	50
Subsides	50	70
Chalk Sandstone	70	100
sand & gravel	100	112

WELL LOCATION:
 sec. 27 T. 2 N R. 9 E
 11 miles S. SE of Magnolia
 (distance) (direction) (nearest town)

WELL PURPOSE: Home
 (home, irrigation, municipal, industrial)

WELL COMPLETION DATA:
 (1) diameter (inches) 4"
 (2) total depth (feet) 112'
 (3) static water level (feet) 80 below above top of ground.
 (4) casing plastic bottom (material) (depth)
 (size) if telescope see back.
 (5) screen 6" 106" (length) (depth to top)
 1/2" plastic (size) (material)
 (6) pump 1/2 HP 1.0 (HP) (yield gpm).
 elect (type power)
 (7) electric log no- (yes or no)
 (organization running log)

(8) how well bottom plugged
 well plugged


DRILLERS REMARKS:
 4

RECEIVED
 MAR 21 1977

MISS. Bd. OF WATER COMM

If well telescopes please sketch and show depths.

GROUND LEVEL

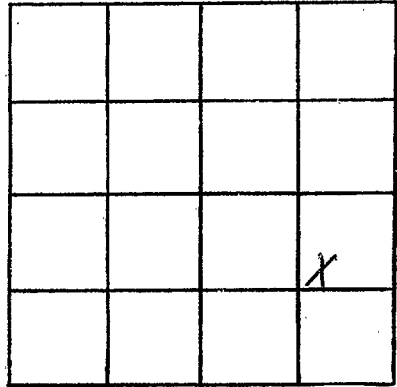

SECTION 27

Please indicate well location X.

ADDITIONAL INFORMATION

If more than one screen, show locations of each on sketch.