

Pike
 J 2025
 1-25-77

MISSISSIPPI
 BOARD OF WATER COMMISSIONERS
 416 North State Street
 1324 Jackson, Mississippi 39201

⑦

WATER WELL DRILLERS LOG

Jan 25 1978 Recess Well Dr Pike
 date well completed firm name county well located

LANDOWNER:
Pink Hill Bapt. Church
Box 2-711
Corumb
 (mailing address)

description of formations encountered	from	to
<u>Red Clay</u>	<u>0</u>	<u>22</u>
<u>sand & gravel</u>	<u>22</u>	<u>75</u>
<u>Red Chalk</u>	<u>75</u>	<u>80</u>
<u>sand & gravel</u>	<u>80</u>	<u>98</u>
<u>blue Chalk</u>	<u>98</u>	<u>160</u>
<u>Orange sand</u>	<u>160</u>	<u>176</u>

WELL LOCATION:
 sec. 15 T 2 N R 9 E
4 miles S-SE of Palmer
 (distance) (direction) (nearest town)

WELL PURPOSE: church
 (home, irrigation, municipal, industrial)

WELL COMPLETION DATA:

(1) diameter (inches) 4"

(2) total depth (feet) 176

(3) static water level (feet) 80 below top of ground.

(4) casing Plastic (material) bottom (depth)

1 if telescope see back.
 (size)

(5) screen 6' (length) 170' (depth to top)
4" (size) Plastic (material)

(6) pump 1/2 hp (HP) 10 (yield gpm)
split (type power)

(7) electric log no (yes or no)


(organization running log)

(8) how well bottom plugged
Modern plug

DRILLERS REMARKS:

If well telescopes please
sketch and show depths.

GROUND LEVEL

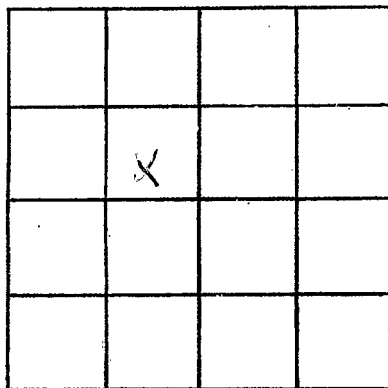

SECTION 15

Please indicate well location X.

ADDITIONAL INFORMATION

If more than one screen,
show locations of each on sketch.