

PIKE
J 208e
10-28-78

MISSISSIPPI
 BOARD OF WATER COMMISSIONERS
 416 North State Street
 Jackson, Mississippi 39201

WATER WELL DRILLERS LOG

Oct 28 1978 Reem weller Pike
 date well completed firm name county well located

LANDOWNER:
Mason Jackson
Rt 2 McLomb
 (mailing address)

description of formations encountered	from	to
clay	0	18
red sand	18	60
sandy loam	60	105
sand & gravel	105	116

WELL LOCATION:
 sec. 15 T 2 N R 9 E
9 miles east of Magnolia
 (distance) (direction) (nearest town)

WELL PURPOSE: 7 miles
 (home, irrigation, municipal, industrial)

WELL COMPLETION DATA:

(1) diameter (inches) 4"

(2) total depth (feet) 116

(3) static water level (feet) 83 below top of ground

(4) casing plastic bottom
 (material) (depth)

(size) if telescope see back.

(5) screen 3' 111'
 (length) (depth to top)

4" plastic
 (size) (material)

(6) pump 2 1/2 hp 10
 (HP) (yield gpm)

split
 (type power)

(7) electric log no
 (yes or no)

(organization running log)

(8) how well bottom plugged:
Welder plug

DRILLERS REMARKS:


Miss. Board of Water Comm.

FEB 15 1979

RECEIVED

If well telescopes please sketch and show depths.

GROUND LEVEL

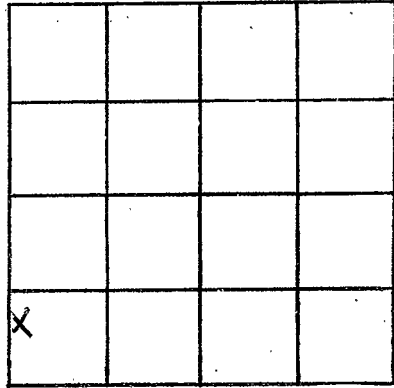

SECTION 15

Please indicate well location X.

ADDITIONAL INFORMATION

If more than one screen,
show locations of each on sketch.