

PIKE

J 2027

12-08-78

MISSISSIPPI  
 BOARD OF WATER COMMISSIONERS  
 416 North State Street  
 Jackson, Mississippi 39201

WATER WELL DRILLERS LOG

12-8  
date well completed

19 78 Fitzgerald Well Sew  
firm name

Pike  
county well located

LANDOWNER:	description of formations encountered	from	to
W.B. Smith R.R. M'comb, Ms. (mailing address)	Red clay white + blue clay Coarse sand + gravel	0 20 130	20 130 140
<p>WELL LOCATION:</p> <p>sec. <u>3</u> T-<u>2</u> N R-<u>9</u> E S W</p> <p><u>10</u> miles <u>E</u> of <u>Magnolia</u> (distance) (direction) (nearest town)</p>			
<p>WELL PURPOSE: <u>Home</u> (home, irrigation, municipal, industrial)</p>			
<p>WELL COMPLETION DATA:</p> <p>(1) diameter (inches) <u>4</u></p> <p>(2) total depth (feet) <u>140</u></p> <p>(3) static water level (feet) <u>30</u> below top of ground.</p> <p>(4) casing <u>PVC</u>, <u>132</u>, (material) (depth) <u>4</u> if telescope see back. (size)</p> <p>(5) screen <u>8</u>, <u>132</u> (length) (depth to top) <u>4</u>, <u>PVC</u> (size) (material)</p> <p>(6) pump <u>1/2</u>, <u>70</u> (HP) (yield gpm) <u>elec</u> (type power)</p> <p>(7) electric log <u>No</u> (yes or no) (organization running log)</p> <p>(8) how well bottom plugged <u>Sand Head</u></p>			
<p>DRILLERS REMARKS:</p>			


RECEIVED

JAN 26 1978

MISS. BD. OF WATER COMMISSIONERS

If well telescopes please sketch and show depths.

GROUND LEVEL

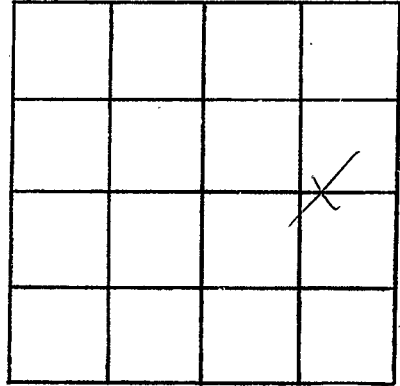

SECTION 3

Please indicate well location X.

ADDITIONAL INFORMATION

If more than one screen, show locations of each on sketch.