

PIKE

J 2008

10-5-78

MISSISSIPPI BOARD OF WATER COMMISSIONERS 416 North State Street Jackson, Mississippi 39201

WATER WELL DRILLERS LOG

10-5 date well completed 19 78 Fitzgerald well, Inc firm name Pike county well located

LANDOWNER: Louis Buzgers R.R. Magnolia ms - (mailing address)

Table with 3 columns: description of formations encountered, from, to. Entries: Red clay (0-20), Red sand (20-120), Coarse sand & gravel (120-142)

WELL LOCATION: sec. 30 T 2 N R 9 E S W 10 miles E of Magnolia (distance) (direction) (nearest town)

WELL PURPOSE: Home (home, irrigation, municipal, industrial)

- WELL COMPLETION DATA: (1) diameter (inches) 4 (2) total depth (feet) 142 (3) static water level (feet) 105 below top of ground. (4) casing PVC, 134 (material) (depth) 4 (size) if telescope see back. (5) screen 8, 1.34 (length) (depth to top) 4 (size) PVC (material) (6) pump 1/2, 10 (HP) (yield gpm) Elec (type power) (7) electric log no (yes or no) (organization running log) (8) how well bottom plugged Sand blk


DRILLERS REMARKS:

RECEIVED DEC-7 1978

MISS. BD. OF WATER COMMISSIONERS

If well telescopes please sketch and show depths.

GROUND LEVEL

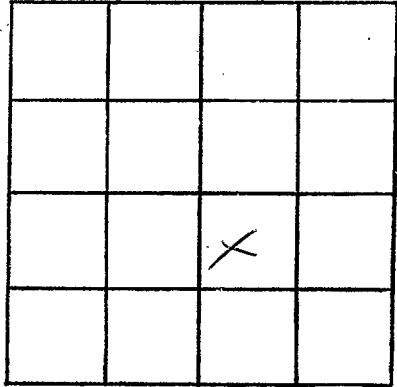

SECTION 30

Please indicate well location X.

ADDITIONAL INFORMATION

If more than one screen,
show locations of each on sketch.