

PIKE

J

2029

11-20-78

MISSISSIPPI
 BOARD OF WATER COMMISSIONERS
 416 North State Street
 Jackson, Mississippi 39201

WATER WELL DRILLERS LOG

11-20 1978 date well completed
 Fitzgerald Well Serv firm name
 Pike county well located

LANDOWNER:
 Harvey Cook
 P.O. Box 211
 (mailing address)

description of formations encountered	from	to
	Red Clay	0
Red sand	20	110
Coarse sand & gravel	110	128

WELL LOCATION:
 sec. 22 T 2 N R 9 E
 S W
 9 miles E of 211
 (distance) (direction) (nearest town)

WELL PURPOSE: Home
 (home, irrigation, municipal, industrial)

- WELL COMPLETION DATA:
- (1) diameter (inches) 4
 - (2) total depth (feet) 128
 - (3) static water level (feet) 85 below top of ground.
 - (4) casing PVC, 120, (material) (depth)
 4 (size) if telescope see back.
 - (5) screen 8, 120 (length) (depth to top)
 4, PVC (size) (material)
 - (6) pump 1/2, 10 (HP) (yield gpm)
 1/2 (type power)
 - (7) electric log No (yes or no)
 (organization running log)
 - (8) how well bottom plugged Seal


DRILLERS REMARKS:

RECEIVED
 DEC - 7 1978

MISS. BD. OF WATER COMMISSIONERS

If well telescopes please sketch and show depths.

GROUND LEVEL

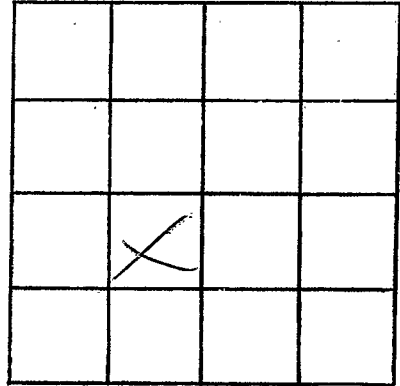

SECTION 22

Please indicate well location X.

ADDITIONAL INFORMATION

Lined area for additional information.

If more than one screen, show locations of each on sketch.