

PIKE
J 2030
5-25-78

MISSISSIPPI
 BOARD OF WATER COMMISSIONERS
 416 North State Street
 Jackson, Mississippi 39201

WATER WELL DRILLERS LOG

May 25 1978 Acacia Well Co Pike
 date well completed firm name county well located

LANDOWNER: <u>Asibiah Barnes</u> <u>Rt Magnolia</u> (mailing address)	description of formations encountered	from	to
WELL LOCATION: sec. <u>17</u> T <u>2</u> N R <u>9</u> E <u>8</u> miles <u>East</u> of <u>Magnolia</u> (distance) (direction) (nearest town)			
WELL PURPOSE: <u>new house</u> (home, irrigation, municipal, industrial)	<u>Red Clay</u>	<u>0</u>	<u>2 1/2</u>
	<u>Red sand</u>	<u>26</u>	<u>76</u>
	<u>Iron & gravel</u>	<u>70</u>	<u>90</u>
	<u>Shaly</u>	<u>90</u>	<u>120</u>
	<u>Sand</u>	<u>120</u>	<u>140</u>

WELL COMPLETION DATA:

(1) diameter (inches) 4"

(2) total depth (feet) 140

(3) static water level (feet) 95 below top of ground.

(4) casing plastic cotton
(material) (depth)
 if telescope see back.
(size)

(5) screen 5' 13.5"
(length) (depth to top)
1/2" plastic
(size) (material)

(6) pump 1/2 HP 10
(HP) (yield gpm)
elect
(type power)

(7) electric log no
(yes or no)

(organization running log)

(8) how well bottom plugged
wooden plug


DRILLERS REMARKS:

RECEIVED
 AUG 28 1978

MISS. BD. OF WATER COMM

If well telescopes please sketch and show depths.

GROUND LEVEL

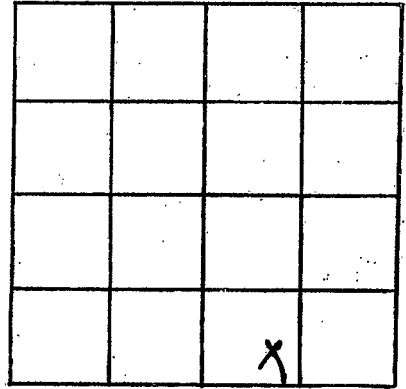

SECTION 17

Please indicate well location X.

ADDITIONAL INFORMATION

If more than one screen,
show locations of each on sketch.