

PIKE
J 2031
4/29/78

MISSISSIPPI
BOARD OF WATER COMMISSIONERS
416 North State Street
Jackson, Mississippi 39201

WATER WELL DRILLERS LOG


April 24 1978 Reams well ser. Pike
date well completed firm name county well located

LANDOWNER:	description of formations encountered	from	to
Earnest M. Gamson	Red Clay	0	18
At 2 Magnolia	Red Fohy sand	18	50
(mailing address)	Chalk, Gravel & sand	50	120
WELL LOCATION:	sand + small gravel	120	136
sec. 5 T 2 N R 9 E			
8 miles S-E of Magnolia			
(distance) (direction) (nearest town)			
WELL PURPOSE: house			
(home, irrigation, municipal, industrial)			
WELL COMPLETION DATA:			
(1) diameter (inches) 4"			
(2) total depth (feet) 136			
(3) static water level (feet) 96 below top of ground.			
(4) casing plastic bottom (material) (depth)			
(size) If telescope see back.			
(5) screen 5' 131' (length) (depth to top)			
4" plastic (size) (material)			
(6) pump 1/2 hp 10 (HP) (yield gpm)			
elect. (type power)			
(7) electric log no (yes or no)			
(organization running log)			
(8) how well bottom plugged wooden plug			
DRILLERS REMARKS:			

RECEIVED
JUN 26 1978

If well telescopes please sketch and show depths.

GROUND LEVEL

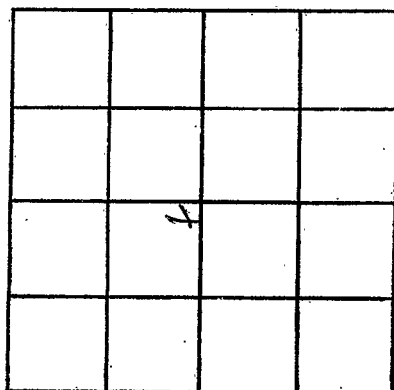

SECTION 5

Please indicate well location X.

ADDITIONAL INFORMATION

If more than one screen,
show locations of each on sketch.