

Pike
 J 2033
 3/15/79

MISSISSIPPI
 BOARD OF WATER COMMISSIONERS
 416 North State Street
 Jackson, Mississippi 39201

WATER WELL DRILLERS LOG

3-15 1979 *Fitzell well* firm name *Pike* county well located

LANDOWNER:
Eppie Estes
R.H. McComb
 (mailing address)

description of formations encountered	from	to
	<i>Red Clay</i>	<i>6</i>
<i>Red sand</i>	<i>20</i>	<i>125</i>
<i>Coarse sand & gravel</i>	<i>125</i>	<i>137</i>

WELL LOCATION:
 sec. 26 T. 21 N. R. 9 E
 1 miles E of Dykes
 (distance) (direction) (nearest town)

WELL PURPOSE: *Home*
 (home, irrigation, municipal, industrial)

- WELL COMPLETION DATA:
- (1) diameter (inches) 4
 - (2) total depth (feet) 137
 - (3) static water level (feet) 95 below above top of ground.
 - (4) casing 100 129
 (material) (depth)
4 if telescope see back.
 (size)
 - (5) screen 8 129
 (length) (depth to top)
4 plc
 (size) (material)
 - (6) pump 1/2 10
 (HP) (yield gpm)
elec
 (type power)
 - (7) electric log no
 (yes or no)
 (organization running log)
 - (8) how well bottom plugged Seal block

DRILLERS REMARKS:


Miss. Board of Water Comm.

MAR 28 1979

RECEIVED

If well telescopes please sketch and show depths.

GROUND LEVEL

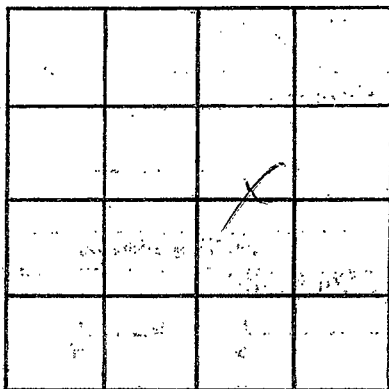

SECTION 26

Please indicate well location X:

ADDITIONAL INFORMATION

If more than one screen, show locations of each on sketch.