

Pike  
 J 2034  
 12-8-79

MISSISSIPPI  
 BOARD OF WATER COMMISSIONERS  
 416 North State Street  
 Jackson, Mississippi 39201

WATER WELL DRILLERS LOG

12-8 1979 *Fitzgerald Sewer* Pike  
 date well completed firm name county well located

LANDOWNER:	description of formations encountered	from	to
<i>Johnny Bonner</i>	<i>Red clay</i>	0	20
<i>R.R. McComb Ms.</i> (mailing address)	<i>Red sand</i>	20	80
WELL LOCATION:	<i>Red gravel</i>	80	120
sec. <u>6</u> T. <u>2</u> N. R. <u>9</u> E S W <u>8</u> miles <u>SE</u> of <u>McComb</u> (distance) (direction) (nearest town)	<i>Coarse sand &amp; gravel</i>	120	140
WELL PURPOSE: <u>Home</u> (home, irrigation, municipal, industrial)			
WELL COMPLETION DATA:			
(1) diameter (inches) <u>4</u>			
(2) total depth (feet) <u>140</u>			
(3) static water level (feet) <u>110</u> below top of ground.			
(4) casing <u>PVC</u> , <u>132</u> , (material) (depth) <u>4</u> (size) if telescope see back.			
(5) screen <u>8</u> , <u>132</u> (length) (depth to top)			
(6) pump <u>4</u> , <u>PVC</u> (size) (material)			
(6) pump <u>1/2</u> <u>10</u> (HP) (yield gpm) <u>elec</u> (type power)			
(7) electric log <u>No</u> (yes or no)			
(organization running log)			
(8) how well bottom plugged <u>Sand block</u>			

DEPT. OF NATURAL RESOURCES  
 BUREAU OF LAND & WATER RESOURCES


JAN 31 1980

RECEIVED

DRILLERS REMARKS:

If well telescopes please sketch and show depths.

GROUND LEVEL

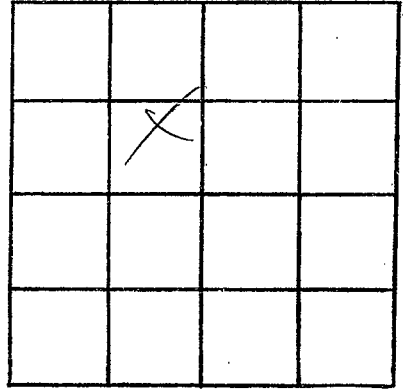

SECTION 6

Please indicate well location X.

ADDITIONAL INFORMATION

If more than one screen,  
show locations of each on sketch.