

PIKE

~~J 2035~~
J 2035
9-22-79

MISSISSIPPI
BOARD OF WATER COMMISSIONERS
416 North State Street
Jackson, Mississippi 39201

WATER WELL DRILLERS LOG

Sept 22 1979 *Reynolds* *Pike*
date well completed firm name county well located

LANDOWNER:
Jesse Sibly
Rt 2 Magnolia
(mailing address)

description of formations encountered	from	to
<i>Clay</i>	<i>0</i>	<i>17</i>
<i>Red sand</i>	<i>17</i>	<i>85</i>
<i>Spud ground</i>	<i>85</i>	<i>110</i>
<i>Chalk</i>	<i>110</i>	<i>140</i>
<i>fine sand</i>	<i>140</i>	<i>155</i>
<i>Coarse sand</i>	<i>155</i>	<i>170</i>
<i>plazground</i>		

WELL LOCATION:
sec. *4* T. *2* N. R. *9* E
9 miles *east* of *Magnolia*
(distance) (direction) (nearest town)

WELL PURPOSE: *home*
(home, irrigation, municipal, industrial)

- WELL COMPLETION DATA:
- (1) diameter (inches) *4"*
 - (2) total depth (feet) *170*
 - (3) static water level (feet) *105* below top of ground.
 - (4) casing *plastic bottom*
(material) (depth)
 If telescope see back.
(size)
 - (5) screen *5'* *165'*
(length) (depth to top)
4" *plastic*
(size) (material)
 - (6) pump *1/2* *10*
(HP) (yield gpm)
elect
(type power)
 - (7) electric log *no*
(yes or no)
- (organization running log)

(8) how well bottom plugged
water plugs

DRILLERS REMARKS:
[Signature]


DEPT. OF NATURAL RESOURCES
BUREAU OF LAND & WATER RESOURCES

SEP 2 - 1980

RECEIVED

If well telescopes please sketch and show depths.

GROUND LEVEL

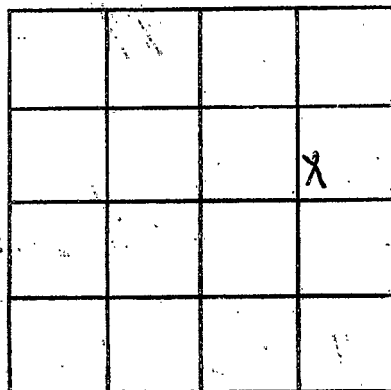

SECTION 4

Please indicate well location X.

ADDITIONAL INFORMATION

If more than one screen, show locations of each on sketch.