

BOARD OF WATER COMMISSIONERS
416 North State Street
Jackson, Mississippi 39201

PEKE
T 2036
8-21-79
Aug 21
date well completed

WATER WELL DRILLERS LOG

1979 Peunmill Sec Peke
firm name county well located

LANDOWNER: Norman Jean Ver
Rt 2 m 11 Comb - Norman
(mailing address)

description of formations encountered	from	to
	<u>clay</u>	<u>0</u>
<u>sand & gravel</u>	<u>12</u>	<u>38</u>
<u>pink chalk</u>	<u>38</u>	<u>70</u>
<u>sand</u>	<u>70</u>	<u>90</u>
<u>loamly + chalk</u>	<u>90</u>	<u>165</u>
<u>pl. gravel</u>	<u>165</u>	<u>180</u>
<u>thin sand</u>		

WELL LOCATION:
sec. 3 T 2 N R 9 E
4 miles SSE of Homelake
(distance) (direction) (nearest town)

WELL PURPOSE: Trailer
(home, irrigation, municipal, industrial)

WELL COMPLETION DATA:
(1) diameter (inches) 4"
(2) total depth (feet) 180
(3) static water level (feet) Eleven below above top of ground.
(4) casing plastic bottom
(material) (depth)
 If telescope see back.
(5) screen 10' 170
(length) (depth to top)
4" plastic
(size) (material)
(6) pump 1/2 HP 10
(HP) (yield gpm)
elect
(type power)
(7) electric log no
(yes or no)
(organization running log)

(8) how well bottom plugged Wooden Plug
DRILLERS REMARKS:


DEPT. OF NATURAL RESOURCES
BUREAU OF LAND & WATER

JUN 25 198

RECEIVED

If well telescopes please sketch and show depths.

GROUND LEVEL

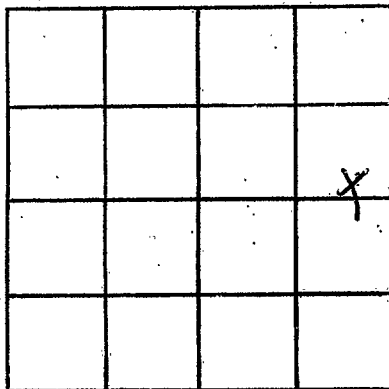

SECTION 3

Please indicate well location X.

ADDITIONAL INFORMATION

If more than one screen,
show locations of each on sketch.