

PIKE

J 2037

MISSISSIPPI BOARD OF WATER COMMISSIONERS
416 North State Street
Jackson, Mississippi 39201

8-10-79

WATER WELL DRILLERS LOG

Aug-10 1979

Run water

Pike

date well completed

firm name

county well located

LANDOWNER:

Slim Brunfield
At-2 M^cComb
(mailing address)

description of formations encountered

from to

clay 0 76
red sand 26 85
blue chalk 85 165
fine sand 165 215
Med. Coarse sand 215 235

WELL LOCATION:

sec 8 T 2 N R 9 E
8 1/2 miles E, SE of M^cComb
(distance) (direction) (nearest town)

WELL PURPOSE: home
(home, irrigation, municipal, industrial)

WELL COMPLETION DATA:

- (1) diameter (inches) 4"
- (2) total depth (feet) 235
- (3) static water level (feet) 118 below top of ground
- (4) casing plastic bottom (material) (depth)
- (5) screen 10' length, 225' depth to top, 4" size, plastic material
- (6) pump 1/2 HP, 10 yield gpm, electric type power
- (7) electric log NO (yes or no)
- (organization running log)

(8) how well bottom plugged

wood plug

DRILLERS REMARKS:

✓


DEPT. OF NATURAL RESOURCES
BUREAU OF LAND & WATER RESOURCES

MAY 20 1980

RECEIVED

If well telescopes please sketch and show depths.

GROUND LEVEL

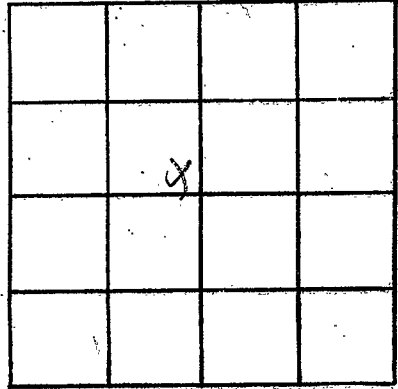

SECTION 8

Please indicate well location X.

ADDITIONAL INFORMATION

If more than one screen, show locations of each on sketch.