

Pike
J 2038
5-9-79

MISSISSIPPI
 BOARD OF WATER COMMISSIONERS
 416 North State Street
 Jackson, Mississippi 39201

WATER WELL DRILLERS LOG

May 9 1979 Peewee Miller Pike
 date well completed firm name county well located

LANDOWNER:
Jesse Hall
 (mailing address)

description of formations encountered	from	to
<u>sandy clay</u>	<u>0</u>	<u>18</u>
<u>small gravel</u>	<u>18</u>	<u>35</u>
<u>chalk</u>	<u>35</u>	<u>60</u>
<u>shaly & cherty</u>	<u>60</u>	<u>145</u>
<u>fine gravel & sand</u>	<u>145</u>	<u>178</u>

WELL LOCATION:
 sec. 3 T 2 N R 9 E
9 miles ESE of MO, Comb
 (distance) (direction) (nearest town)

WELL PURPOSE: camp
 (home, irrigation, municipal, industrial)

- WELL COMPLETION DATA:
- (1) diameter (inches) 4"
 - (2) total depth (feet) 178'
 - (3) static water level (feet) Flow ^{below} 390' per ^{above} top of ground
 - (4) casing plastic, bottom
 (material) (depth)
 - If telescope see back.
 (size)
 - (5) screen 10' 168'
 (length) (depth to top)
 - 4" plastic
 (size) (material)
 - (6) pump 5 Sub 90
 (HP) (yield gpm)
 - elect
 (type power)
 - (7) electric log no
 (yes or no)

(organization running log)
 (8) how well bottom plugged Wooden plug


DRILLERS REMARKS:
—

DEPT. OF NATURAL RESOURCES
 BUREAU OF LAND & WATER RESOURCES

OCT 10 1979
 RECEIVED

If well telescopes please
sketch and show depths.

GROUND LEVEL

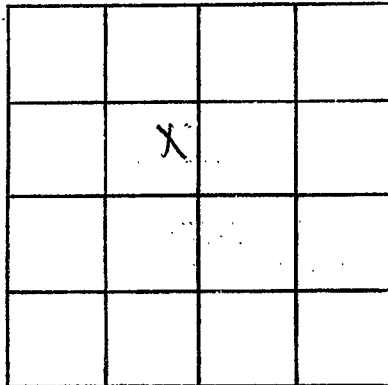

SECTION 3

Please indicate well location X.

ADDITIONAL INFORMATION

If more than one screen,
show locations of each on sketch.