

Pike  
J 203

MISSISSIPPI  
BOARD OF WATER COMMISSIONERS  
416 North State Street  
Jackson, Mississippi 39201

WATER WELL DRILLERS LOG

8-30-79  
8-30 19 79 Fitzgerald Well Serv  
date well completed firm name county well located Pike

LANDOWNER:  
Julius Bullack  
P.O. - McComb, Miss  
(mailing address)

description of formations encountered	from	to
Red clay	0	20
Red sand	20	80
Coarse sand & gravel	80	95

WELL LOCATION:  
sec. 6 T 2 N R 9 E  
S W  
8 miles E of McComb  
(distance) (direction) (nearest town)

WELL PURPOSE: Home  
(home, irrigation, municipal, industrial)

- WELL COMPLETION DATA:
- (1) diameter (inches) 4
  - (2) total depth (feet) 95
  - (3) static water level (feet) 40 below top of ground.
  - (4) casing PVC 87 (material) (depth)  
4 (size) if telescope see back.
  - (5) screen 8 87 (length) (depth to top)  
4 (size) PVC (material)
  - (6) pump 1/2 10 (HP) (yield gpm)  
Elec (type power)
  - (7) electric log no (yes or no)
  - (8) how well bottom plugged Sand & sh.

DRILLERS REMARKS:


Miss. Board of Water Comm.

SEP 12 1979

RECEIVED

If well telescopes please sketch and show depths.

GROUND LEVEL

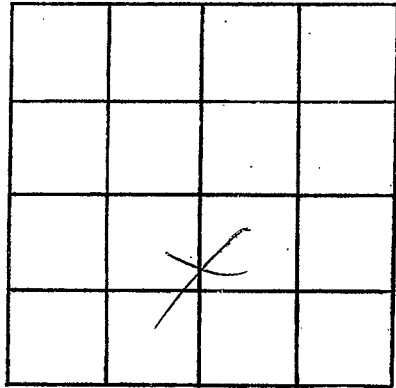

SECTION 6

Please indicate well location X.

ADDITIONAL INFORMATION

If more than one screen, show locations of each on sketch.