

PIKE
 J 2041
 4-18-79

MISSISSIPPI
 BOARD OF WATER COMMISSIONERS
 416 North State Street
 Jackson, Mississippi 39201

WATER WELL DRILLERS LOG

4-18
 date well completed

1979 *Fitzgerald*
 firm name

Rate
 county well located

LANDOWNER:
James Rutledge
RR 277 Comb
 (mailing address)

description of formations encountered	from	to
<i>Red clay</i>	<i>0</i>	<i>20</i>
<i>Red sand</i>	<i>20</i>	<i>90</i>
<i>Blue clay</i>	<i>90</i>	<i>150</i>
<i>Coarse sand & gravel</i>	<i>150</i>	<i>180</i>

WELL LOCATION:
 sec. *10* T. *2* N. R. *9* E.
 S W
10 miles *SE* of *Comb*
 (distance) (direction) (nearest town)

WELL PURPOSE: *Home*
 (home, irrigation, municipal, industrial)

- WELL COMPLETION DATA:
- (1) diameter (inches) *4*
 - (2) total depth (feet) *180*
 - (3) static water level (feet) *90* below above top of ground.
 - (4) casing *1 1/2*, *172*
 (material) (depth)
4 if telescope see back.
 (size)
 - (5) screen *8*, *172*
 (length) (depth to top)
4, *1 1/2*
 (size) (material)
 - (6) pump *1/2*, *10*
 (HP) (yield gpm)
Electric
 (type power)
 - (7) electric log *no*
 (yes or no)
 (organization running log)
 - (8) how well bottom plugged *Sand Shale*

DRILLERS REMARKS:


Miss. Board of Water Comm.

MAY 30 1979

RECEIVED

If well telescopes please sketch and show depths.

GROUND LEVEL

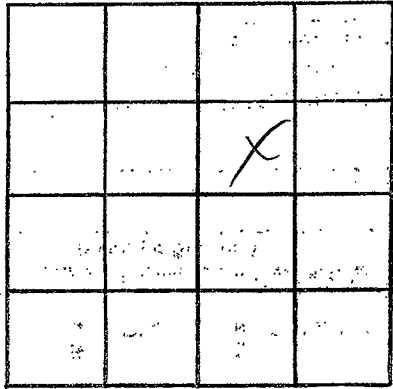

SECTION 10

Please indicate well location X.

ADDITIONAL INFORMATION

If more than one screen, show locations of each on sketch.