

PIKE
 J 2042
 01-04-79

MISSISSIPPI
 BOARD OF WATER COMMISSIONERS
 416 North State Street
 Jackson, Mississippi 39201

WATER WELL DRILLERS LOG

Jan 4 1979 Reems Miller Pike
 date well completed firm name county well located

LANDOWNER:
Willie Craft
Rt Magnolia
 (mailing address)

description of formations encountered	from	to
<u>Red sand clay</u>	<u>0</u>	<u>22</u>
<u>Red sand</u>	<u>22</u>	<u>70</u>
<u>Sand & gravel</u>	<u>70</u>	<u>105</u>
<u>pebb Chalk -</u>	<u>105</u>	<u>118</u>
<u>Coarse sand & gravel</u>	<u>118</u>	<u>135</u>

WELL LOCATION:
 sec. 29 T. 2 N. R. 9 E
9 miles E.S.E of Magnolia
 (distance) (direction) (nearest town)

WELL PURPOSE: home
 (home, irrigation, municipal, industrial)

WELL COMPLETION DATA:

(1) diameter (inches) 4"

(2) total depth (feet) 135

(3) static water level (feet) 105 ^{below} _{above} top of ground.

(4) casing plastic bottom
 (material) (depth)

4" If telescope see back.
 (size)

(5) screen 5" 130'
 (length) (depth to top)

4" plastic
 (size) (material)

(6) pump 1/2 10
 (HP) (yield gpm)

electric
 (type power)

(7) electric log no
 (yes or no)

(organization running log)

(8) how well bottom plugged
wooden plug

DRILLERS REMARKS:


Miss. Board of Water Comm.

APR 26 1979

RECEIVED

If well telescopes please
sketch and show depths.

GROUND LEVEL

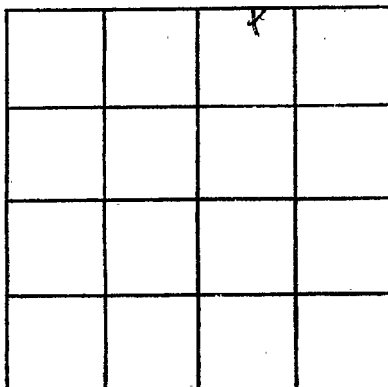

SECTION 29

Please indicate well location X.

ADDITIONAL INFORMATION

If more than one screen,
show locations of each on sketch.