

MISSISSIPPI DEPARTMENT OF NATURAL RESOURCES

Bureau of Land and Water Resources

Southport Mall

P.O. Box 10631

Jackson, Mississippi 39209

WATER WELL DRILLERS LOG

Pike
J 2046
1-9-80

Jan 9 1980 Reeves Well Serv. Pike
date well completed firm name county well located

LANDOWNER:	description of formations encountered	from	to
Alma Strickland	Red Clay	0	18
Rt 2 in G Comb - (mailing address)	Red sand	18	60
WELL LOCATION:	sand & gravel	60	85
sec. 23 T 2 N R 9 E	loam	85	130
7 miles ESE of Magnolia	Gravel & sand	130	142
(distance) (direction) (nearest town)			
WELL PURPOSE: new house			
(home, irrigation, municipal, industrial)			
WELL COMPLETION DATA:			
(1) diameter (inches) 4"			
(2) total depth (feet) 142			
(3) static water level (feet) 98 below top of ground			
(4) casing plastic bottom (material) (depth)			
(5) screen 5' 137" (length) (depth to top)			
(6) pump 1/2 sub 10 (HP) (yield gpm)			
elec (type power)			
(7) electric log no (yes or no)			
(organization running log)			
(8) how well bottom plugged			
Backwash Valve			
DRILLERS REMARKS:			


DEPT. OF NATURAL RESOURCES
BUREAU OF LAND & WATER RESOURCES

NOV 14 1980

RECEIVED

If well telescopes please sketch and show depths.

GROUND LEVEL

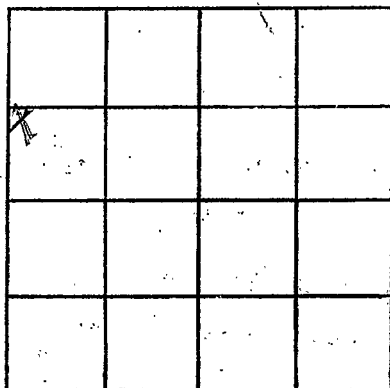

SECTION 23

Please indicate well location X.

ADDITIONAL INFORMATION

If more than one screen,
show locations of each on sketch.