

Pike
J 2047
4-26-80

MISSISSIPPI
 BOARD OF WATER COMMISSIONERS
 416 North State Street
 Jackson, Mississippi 39201

WATER WELL DRILLERS LOG

4-26 1980 Thermalwell Inc Pike
 date well completed firm name county well located

LANDOWNER:

Willie Lee McComb

R.R. McComb
 (mailing address)

WELL LOCATION:

sec. 6 T 2 (N) R 9 (E)
9 miles E of McComb
 (distance) (direction) (nearest town)

WELL PURPOSE: Home
 (home, irrigation, municipal, industrial)

WELL COMPLETION DATA:

- (1) diameter (inches) 4
- (2) total depth (feet) 140
- (3) static water level (feet) 95 below above top of ground.
- (4) casing PVC, 132,
 (material) (depth)
4 If telescope see back.
 (size)
- (5) screen 8, 132
 (length) (depth to top)
4, PVC
 (size) (material)
- (6) pump 1/2, 50
 (HP) (yield gpm)
Elc
 (type power)
- (7) electric log 2
 (yes or no)
Sanford
 (organization running log)
- (8) how well bottom plugged Sand

description of formations encountered

from to

<u>Red clay</u>	<u>0</u>	<u>20</u>
<u>Red gravel</u>	<u>20</u>	<u>90</u>
<u>Red sand</u>	<u>90</u>	<u>125</u>
<u>Coarse sand & gravel</u>	<u>125</u>	<u>140</u>

DRILLERS REMARKS:


DEPT. OF NATURAL RESOURCES
 BUREAU OF LAND & WATER RESOURCES

JUN 20 1980

RECEIVED

If well telescopes please sketch and show depths.

GROUND LEVEL

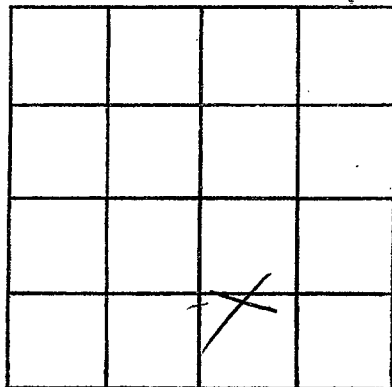

SECTION 6

Please indicate well location X.

ADDITIONAL INFORMATION

If more than one screen,
show locations of each on sketch.