

PIKE  
J 2048  
1-2-81

MISSISSIPPI  
 BOARD OF WATER COMMISSIONERS  
 416 North State Street  
 Jackson, Mississippi 39201

WATER WELL DRILLERS LOG

1-2 1981 Fitzell well serv Pike  
 date well completed firm name county well located

LANDOWNER:	description of formations encountered	from	to
<u>Nellie Robinson</u>			
<u>R.R. McManis</u> (mailing address)	<u>Red clay</u>	<u>0</u>	<u>20</u>
	<u>Red sand &amp; gravel</u>	<u>20</u>	<u>100</u>
	<u>Coarse sand &amp; gravel</u>	<u>100</u>	<u>120</u>
WELL LOCATION:			
sec. <u>29</u> T <u>2</u> N R <u>9</u> E S W			
<u>9</u> miles <u>E</u> of <u>MASADA</u> (distance) (direction) (nearest town)			
WELL PURPOSE: (home, irrigation, municipal, industrial)			
<u>Home</u>			
WELL COMPLETION DATA:			
(1) diameter (inches) <u>4</u>			
(2) total depth (feet) <u>120</u>			
(3) static water level (feet) <u>95</u> below top of ground.			
(4) casing <u>PVC 112</u> , (material) (depth) <u>4</u> (size) if telescope see back.			
(5) screen <u>8 112</u> (length) (depth to top) <u>4</u> , <u>PVC</u> (size) (material)			
(6) pump <u>1/2 10</u> (HP) (yield gpm) <u>Electric</u> (type power)			
(7) electric log <u>no</u> (yes or no)			
(organization running log)			
(8) how well bottom plugged <u>Paul Hink</u>			
DRILLERS REMARKS:			


DEPT. OF NATURAL RESOURCES  
 BUREAU OF LAND & WATER RESOURCES

JAN 20 1981

RECEIVED

If well telescopes please sketch and show depths.

GROUND LEVEL

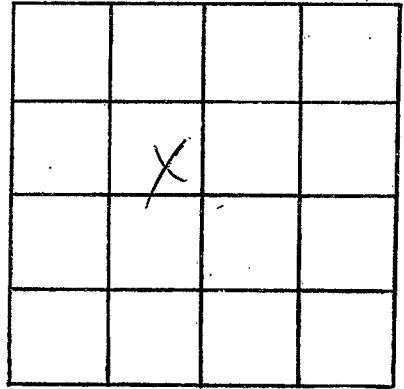

SECTION 29

Please indicate well location X.

ADDITIONAL INFORMATION

If more than one screen,  
show locations of each on sketch.