

**MISSISSIPPI
BOARD OF WATER COMMISSIONERS
416 North State Street
Jackson, Mississippi 39201**

WATER WELL DRILLERS LOG

Pelae
J 2019
10-8-81

10-8

date well completed

1981

Fitzpatrick Inc

firm name

Pelae

county well located

LANDOWNER:	description of formations encountered	from	to
<u>Pally-mage</u> <u>RR 2776 Lombom.</u> (mailing address)			
WELL LOCATION: sec. <u>8</u> T. <u>2</u> N. R. <u>9</u> E. S W <u>1</u> miles <u>S</u> of <u>Barto</u> (distance) (direction) (nearest town)			
WELL PURPOSE: <u>Home</u> (home, irrigation, municipal, industrial)			
WELL COMPLETION DATA: (1) diameter (inches) <u>4</u> (2) total depth (feet) <u>140</u> (3) static water level (feet) <u>100</u> below top of ground. (4) casing <u>PVC</u> , <u>132</u> (material) (depth) <u>4</u> if telescope see back. (size) (5) screen <u>8</u> , <u>132</u> (length) (depth to top) <u>4</u> , <u>PVC</u> (size) (material) (6) pump <u>1/2</u> , <u>10</u> (HP) (yield gpm) <u>Electric</u> (type power) (7) electric log <u>no</u> (yes or no) (organization running log) (8) how well bottom plugged <u>Sealed</u>			
DRILLERS REMARKS:			


DEPT. OF NATURAL RESOURCES
BUREAU OF LAND & WATER RESOURCES

NOV 20 1981

RECEIVED

If well telescopes please sketch and show depths.

GROUND LEVEL

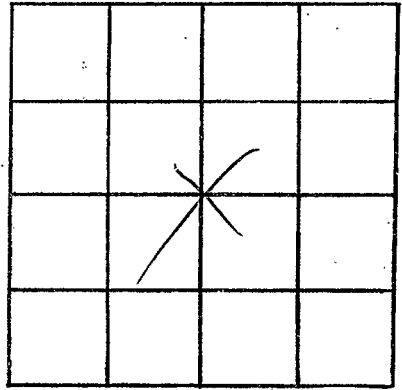

SECTION 8

Please indicate well location X.

ADDITIONAL INFORMATION

If more than one screen,
show locations of each on sketch.