

MISSISSIPPI DEPARTMENT OF NATURAL RESOURCES

Bureau of Land and Water Resources

Southport Mall

P.O. Box 10631

Jackson, Mississippi 39209

WATER WELL DRILLERS LOG

Pike
8205

Aug 23 1981
date well completed

Reverend Miller Pike
firm name

Pike
county well located

LANDOWNER:	description of formations encountered	from	to
<u>O. J. Champagne</u> <u>At 2 N^o Conde</u> (mailing address)	<u>Sandy clay</u>	<u>0</u>	<u>17</u>
WELL LOCATION: sec. <u>3</u> T <u>2</u> N R. <u>9</u> E <u>in Park area</u> (distance) (direction) (nearest town)	<u>Chalky sand</u>	<u>17</u>	<u>50</u>
WELL PURPOSE: <u>Camp</u> (home, irrigation, municipal, industrial)	<u>pink + white shell</u>	<u>50</u>	<u>95</u>
WELL COMPLETION DATA:	<u>Red sand</u>	<u>95</u>	<u>130</u>
(1) diameter (inches) <u>4"</u>	<u>loosely</u>	<u>130</u>	<u>185</u>
(2) total depth (feet) <u>225'</u>	<u>Coarse sand +</u>	<u>185</u>	<u>225</u>
(3) static water level (feet) <u>Flow</u> below/above top of ground.	<u>fine gravel</u>		
(4) casing <u>plastic bottom</u> (material) (depth)			
_____ if telescope see back. (size)			
(5) screen <u>10'</u> <u>215'</u> (length) (depth to top)			
_____ <u>plastic</u> (size) (material)			
(6) pump <u>Sub</u> <u>10</u> (HP) (yield gpm)			
<u>elec</u> (type power)			
(7) electric log <u>no</u> (yes or no)			
_____ (organization running log)			
(8) how well bottom plugged <u>observed value</u>			
DRILLERS REMARKS: <u>well flowed</u> <u>5 gal. per min</u>			


DEPT. OF NATURAL RESOURCES
BUREAU OF LAND & WATER RESOURCES

MAR 15 1982

RECEIVED

If well telescopes please sketch and show depths.

GROUND LEVEL

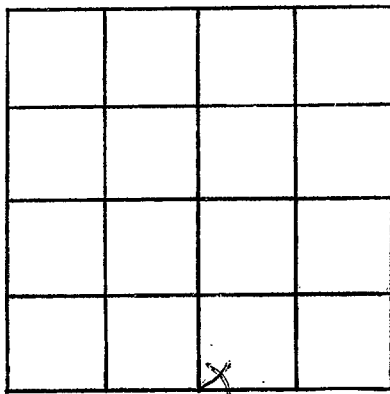

SECTION 3

Please indicate well location X.

ADDITIONAL INFORMATION

Lined area for additional information.

If more than one screen, show locations of each on sketch.