

MISSISSIPPI DEPARTMENT OF NATURAL RESOURCES

Bureau of Land and Water Resources

Southport Mall

P.O. Box 10631

Jackson, Mississippi 39209

WATER WELL DRILLERS LOG

Pike
J 2052
5/5/81

May 5 19 81 Reynoldsville Pike
date well completed firm name county well located

LANDOWNER:	description of formations encountered	from	to
<p>Thomas Corley Rt 2 Mc Cormick (mailing address)</p>			
<p>WELL LOCATION: sec. <u>33</u> T <u>3</u> N R <u>9</u> E <u>10</u> miles <u>E-SE</u> of <u>Mc Cormick</u> (distance) (direction) (nearest town)</p>			
<p>WELL PURPOSE: <u>home</u> (home, irrigation, municipal, industrial)</p>			
<p>WELL COMPLETION DATA:</p> <p>(1) diameter (inches) <u>4 1/2"</u></p> <p>(2) total depth (feet) <u>132</u></p> <p>(3) static water level (feet) <u>120</u> below top of ground.</p> <p>(4) casing <u>plastic bottom</u> (material) (depth)</p> <p>(size) if telescope see back.</p> <p>(5) screen <u>5"</u> <u>127</u> (length) (depth to top)</p> <p><u>4"</u> <u>plastic</u> (size) (material)</p> <p>(6) pump <u>1/2</u> <u>10</u> (HP) (yield gpm)</p> <p><u>elect</u> (type power)</p> <p>(7) electric log <u>no</u> (yes or no)</p> <p>(organization running log)</p> <p>(8) how well bottom plugged <u>Back Wash Valve</u></p>			
<p>DRILLERS REMARKS:</p>			


DEPT. OF NATURAL RESOURCES
BUREAU OF LAND & WATER RESOURCES

OCT - 1 1981

RECEIVED

If well telescopes please sketch and show depths.

GROUND LEVEL

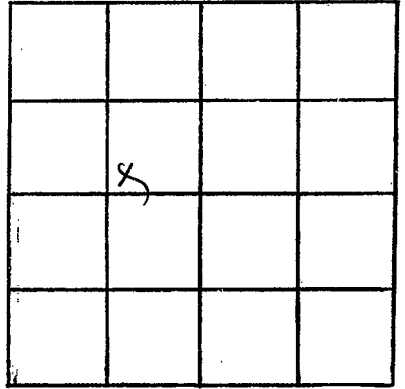

SECTION 33

Please indicate well location X.

ADDITIONAL INFORMATION

If more than one screen, show locations of each on sketch.