


Pcho
J 2053
6-17-81

MISSISSIPPI
BOARD OF WATER COMMISSIONERS
416 North State Street
Jackson, Mississippi 39201

WATER WELL DRILLERS LOG


6-17 1981 Pyramid Well Co Pcho
date well completed firm name county well located

LANDOWNER:	description of formations encountered	from	to
<u>Will Shady</u>			
<u>RR. McCall, Jr.</u> (mailing address)	<u>Red Clay</u>	<u>0</u>	<u>20</u>
	<u>Red Sand & Gravel</u>	<u>20</u>	<u>140</u>
	<u>Gravel Sand & Gravel</u>	<u>140</u>	<u>151</u>
WELL LOCATION:			
sec. <u>9</u> T <u>2</u> N R <u>9</u> E S W			
<u>8</u> miles <u>E</u> of <u>McCall</u> (distance) (direction) (nearest town)			
WELL PURPOSE: <u>Home</u> (home, irrigation, municipal, industrial)			
WELL COMPLETION DATA:			
(1) diameter (inches) <u>4</u>			
(2) total depth (feet) <u>151</u>			
(3) static water level (feet) <u>110</u> below top of ground. above			
(4) casing <u>ASL</u> <u>143</u> (material) (depth)			
<u>4</u> (size) if telescope see back.			
(5) screen <u>8</u> <u>143</u> (length) (depth to top)			
<u>4</u> <u>ASL</u> (size) (material)			
(6) pump <u>1/2</u> <u>10</u> (HP) (yield gpm)			
<u>ch</u> (type power)			
(7) electric log <u>no</u> (yes or no)			
<u>Pyramid Well Co</u> (organization running log)			
(8) how well bottom plugged <u>S. L. McCall</u>			
DRILLERS REMARKS:			

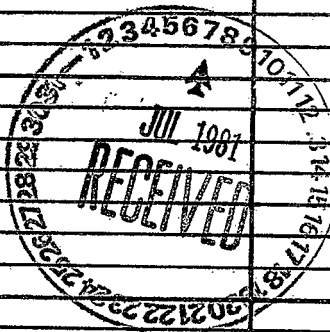

If well telescopes please
sketch and show depths.

GROUND LEVEL

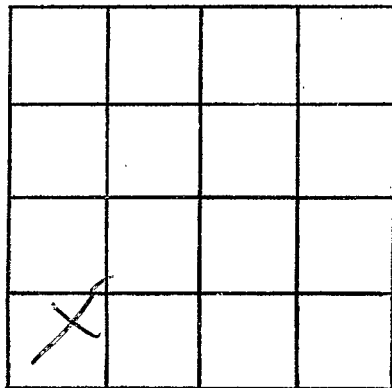

SECTION

9

Please indicate well location X.

ADDITIONAL INFORMATION

If more than one screen,
show locations of each on sketch.