

Pike
2054

MISSISSIPPI
BOARD OF WATER COMMISSIONERS
416 North State Street
Jackson, Mississippi 39201

WATER WELL DRILLERS LOG

5-21
date well completed

1982 F. L. G. well serv
firm name

Pike
county well located

LANDOWNER:
Jimmy Barrett
R.R. McComb Ms.
(mailing address)

description of formations encountered	from	to
Red clay	0	20
Red gravel	20	26
White & blue clay	26	120
Coarse sand & gravel	120	135

WELL LOCATION:
sec. 3 T 2 N R 9 E
S W
9 miles E of McComb
(distance) (direction) (nearest town)

WELL PURPOSE: Home
(home, irrigation, municipal, industrial)

- WELL COMPLETION DATA:
- (1) diameter (inches) 4
 - (2) total depth (feet) 135
 - (3) static water level (feet) 20 below top of ground.
 - (4) casing PVC, 127, (material) (depth)
 - 4 (size) if telescope see back.
 - (5) screen 8, 127 (length) (depth to top)
 - 4 (size) PVC (material)
 - (6) pump 1/2 (HP) 10 (yield gpm)
 - elec (type power)
 - (7) electric log No (yes or no)
 - (organization running log)
 - (8) how well bottom plugged Sand plug

DEPT. OF NATURAL RESOURCES
BUREAU OF LAND & WATER RESOURCES


JUL - 7 1982

RECEIVED

DRILLERS REMARKS:

If well telescopes please sketch and show depths.

GROUND LEVEL

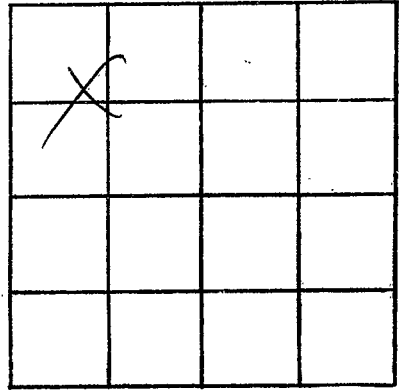

SECTION 3

Please indicate well location X.

ADDITIONAL INFORMATION

If more than one screen, show locations of each on sketch.