

MISSISSIPPI DEPARTMENT OF NATURAL RESOURCES

Bureau of Land and Water Resources

Southport Mall

P.O. Box 10631

Jackson, Mississippi 39209

WATER WELL DRILLERS LOG

Pike
J 2055

Aug 13 1982
date well completed

Perms Miller
firm name

Pike
county well located

LANDOWNER:
Lillie Carter
Rt 1 Magnolia
(mailing address)

description of formations encountered	from	to
	<u>Red clay sand</u>	<u>0</u>
<u>Sand & gravel</u>	<u>18</u>	<u>50</u>
<u>pink clay & sand</u>	<u>50</u>	<u>63</u>
<u>gravel & sand</u>	<u>63</u>	<u>77</u>

WELL LOCATION:
sec. 7 T. 2 N. R. 9 E
1 miles east of Magnolia
(distance) (direction) (nearest town)

WELL PURPOSE: home
(home, irrigation, municipal, industrial)

WELL COMPLETION DATA:

(1) diameter (inches) 4"

(2) total depth (feet) 77'

(3) static water level (feet) 50 below top of ground.

(4) casing plastic, battered
(material) (depth)

5" if telescope see back.
(size)

(5) screen 5" 77'
(length) (depth to top)

4" plastic
(size) (material)

(6) pump by ahus
(HP) (yield gpm)

list
(type power)

(7) electric log no
(yes or no)

no
(organization running log)

(8) how well bottom plugged backwash

DRILLERS REMARKS:


DEPT. OF NATURAL RESOURCES
BUREAU OF LAND & WATER RESOURCES

JAN 13 1983

RECEIVED

If well telescopes please sketch and show depths.

GROUND LEVEL

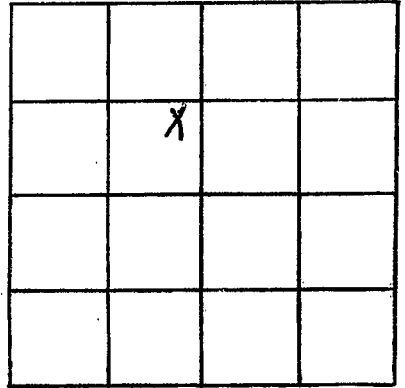

SECTION 7

Please indicate well location X.

ADDITIONAL INFORMATION

If more than one screen, show locations of each on sketch.