

Pine  
J 2056

MISSISSIPPI  
BOARD OF WATER COMMISSIONERS  
416 North State Street  
Jackson, Mississippi 39201

WATER WELL DRILLERS LOG

8-4 date well completed 19 82 Fitzgibbon well serv firm name Pine county well located

LANDOWNER:	description of formations encountered	from	to
<u>Carl Bullback</u>			
<u>P.R. 2 m comb</u> (mailing address)	<u>Red clay</u>	<u>0</u>	<u>20</u>
	<u>Red sand &amp; gravel</u>	<u>20</u>	<u>110</u>
	<u>Coarse sand &amp; gravel</u>	<u>110</u>	<u>126</u>
WELL LOCATION:			
sec. <u>5</u> T. <u>2</u> N R. <u>9</u> E S W			
<u>1</u> miles <u>SW</u> of <u>Barto</u> (distance) (direction) (nearest town)			
WELL PURPOSE: <u>Home</u> (home, irrigation, municipal, industrial)			
WELL COMPLETION DATA:			
(1) diameter (inches) <u>4</u>			
(2) total depth (feet) <u>126</u>			
(3) static water level (feet) <u>75</u> below top of ground. above			
(4) casing <u>pvc</u> , <u>118</u> , (material) (depth)			
<u>4</u> (size) If telescope see back.			
(5) screen <u>8</u> , <u>118</u> (length) (depth to top)			
<u>4</u> , <u>pvc</u> (size) (material)			
(6) pump <u>1/2</u> , <u>10</u> (HP) (yield gpm)			
<u>el</u> (type power)			
(7) electric log <u>no</u> (yes or no)			
(organization running log)			
(8) how well bottom plugged <u>sealed shut</u>			
DRILLERS REMARKS:			


DEPT. OF NATURAL RESOURCES  
BUREAU OF LAND & WATER RESOURCES

OCT 18 1982

RECEIVED

If well telescopes please sketch and show depths.

GROUND LEVEL

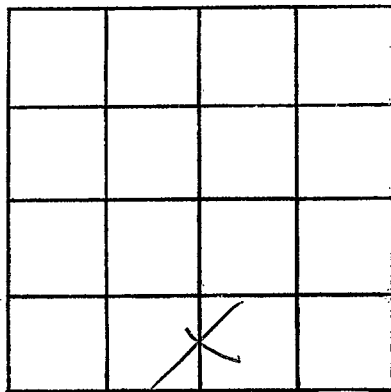

SECTION 5

Please indicate well location X.

ADDITIONAL INFORMATION

If more than one screen, show locations of each on sketch.