

MISSISSIPPI DEPARTMENT OF NATURAL RESOURCES

Bureau of Land and Water Resources

Southport Mall

P.O. Box 10631

Jackson, Mississippi 39209

WATER WELL DRILLERS LOG

| |
|------|
| PIKE |
| J |
| 2059 |

10-28 1983
date well completed

Fitzgerald well
firm name

Pike
county well located

| LANDOWNER: | description of formations encountered | from | to |
|---|---|----------------|------------------|
| Glenn Campbell P.R. 2, m'eb, ms. (mailing address) | Red clay white chert coarse sand & gravel | 0 15 105 | 15 105 119 |
| WELL LOCATION: sec. <u>2</u> T <u>2</u> N R <u>9</u> E S W <u>8</u> miles <u>E</u> of <u>m'eb</u> (distance) (direction) (nearest town) | | | |
| WELL PURPOSE: (home, irrigation, municipal, industrial) | | | |
| WELL COMPLETION DATA: | | | |
| (1) diameter (inches) <u>4</u> | | | |
| (2) total depth (feet) <u>119</u> | | | |
| (3) static water level (feet) <u>1</u> ^{below} above top of ground. | | | |
| (4) casing <u>PVC, 111</u> , (material) (depth) <u>4</u> if telescope see back. (size) | | | |
| (5) screen <u>8</u> , <u>111</u> (length) (depth to top) <u>4</u> , <u>PVC</u> (size) (material) | | | |
| (6) pump <u>1/2</u> , <u>16</u> (HP) (yield gpm) <u>el</u> (type power) | | | |
| (7) electric log <u>no</u> (yes or no) | | | |
| (organization running log) | | | |
| (8) how well bottom plugged <u>Sand Shk</u> | | | |
| DRILLERS REMARKS: | | | |


DEPT. OF NATURAL RESOURCES
BUREAU OF LAND & WATER RESOURCES

DEC - 9 1983

RECEIVED

If well telescopes please
sketch and show depths.

GROUND LEVEL

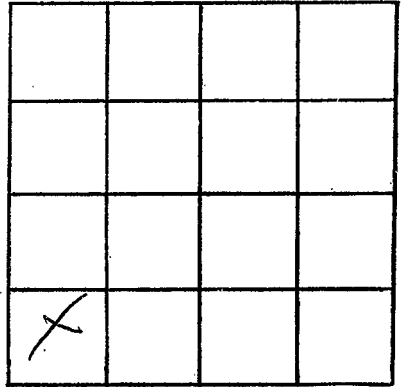

SECTION 2

Please indicate well location X.

ADDITIONAL INFORMATION

If more than one screen,
show locations of each on sketch.