

MISSISSIPPI DEPARTMENT OF NATURAL RESOURCES

Bureau of Land and Water Resources

Southport Mall

P.O. Box 10631

Jackson, Mississippi 39209

WATER WELL DRILLERS LOG

PIKE
J
2002

4-18 1983 *Fitzgerald Well Serv* Pike  
 date well completed firm name county well located

LANDOWNER:  
*Dr. Lane Seltzer*  
*R.R. McComb, Jr.*  
 (mailing address)

description of formations encountered	from	to
<i>Red clay</i>	<i>0</i>	<i>20</i>
<i>Red sand</i>	<i>20</i>	<i>30</i>
<i>white &amp; blue chalk</i>	<i>30</i>	<i>140</i>
<i>Coarse sand &amp; gravel</i>	<i>140</i>	<i>156</i>

WELL LOCATION:  
 sec. 3 T 2 N R 9 E  
                   S                  W  
11 miles E of McComb  
 (distance) (direction) (nearest town)

WELL PURPOSE:  
 (home, irrigation, municipal, industrial)  
Home

- WELL COMPLETION DATA:
- (1) diameter (inches) 4
  - (2) total depth (feet) 156
  - (3) static water level (feet) 32 below above top of ground.
  - (4) casing POC, 146,  
 (material) (depth)  
4  
 (size) If telescope see back.
  - (5) screen 10, 146  
 (length) (depth to top)  
4, POC  
 (size) (material)
  - (6) pump 1/2, 10  
 (HP) (yield gpm)  
Electric  
 (type power)
  - (7) electric log No  
 (yes or no)  
 (organization running log)
  - (8) how well bottom plugged Sealed

DRILLERS REMARKS:


DEPT. OF NATURAL RESOURCES  
 BUREAU OF LAND & WATER RESOURCES

MAY 2 - 1983

RECEIVED

If well telescopes please sketch and show depths.

GROUND LEVEL

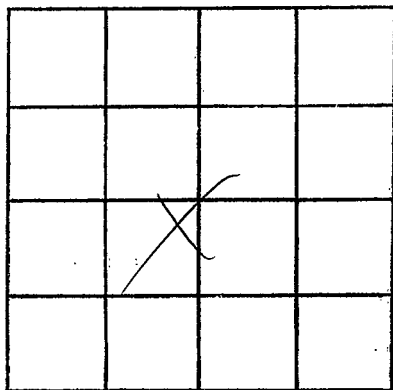

SECTION 3

Please indicate well location X.

ADDITIONAL INFORMATION

If more than one screen,  
show locations of each on sketch.