

MISSISSIPPI DEPARTMENT OF NATURAL RESOURCES

Bureau of Land and Water Resources

Southport Mall

P.O. Box 10631

Jackson, Mississippi 39209

WATER WELL DRILLERS LOG

**PIKE**  
Jax 3

12-20-84  
date well completed

84 *Fleming well ser*  
firm name

*Pike*  
county well located

LANDOWNER:

*mae's Jackson*

*R.R. McLe, Mrs.*  
(mailing address)

description of formations encountered

from

to

<i>Reel clay</i>	<i>0</i>	<i>20</i>
<i>Reel sand</i>	<i>20</i>	<i>60</i>
<i>Reel gravel</i>	<i>60</i>	<i>90</i>
<i>Coarse sand &amp; gravel</i>	<i>90</i>	<i>108</i>

WELL LOCATION:

sec 22 T 2 N R 9 E  
S W  
9 miles E of McLe  
(distance) (direction) (nearest town)

WELL PURPOSE:

*Home*  
(home, irrigation, municipal, industrial)

WELL COMPLETION DATA:


- (1) diameter (inches) 4
- (2) total depth (feet) 108
- (3) static water level (feet) 80 below above top of ground.
- (4) casing PVC, 100  
(material), (depth)  
4 if telescope see back.  
(size)
- (5) screen 8, 100  
(length), (depth to top)  
4, PVC  
(size), (material)
- (6) pump 1/2, 10  
(HP), (yield gpm)  
Elm  
(type power)
- (7) electric log no  
(yes or no)
- (organization running log)
- (8) how well bottom plugged Solid

*Reel 110  
1-7-85*

DRILLERS REMARKS:

If well telescopes please sketch and show depths.

GROUND LEVEL

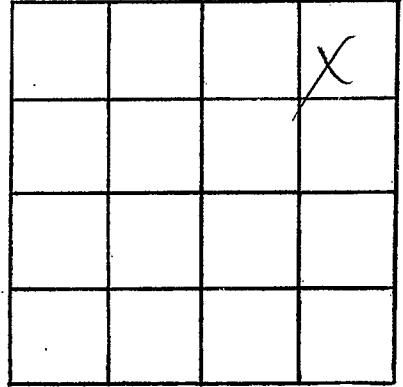

SECTION 22

Please indicate well location X.

ADDITIONAL INFORMATION

If more than one screen,  
show locations of each on sketch.