

MISSISSIPPI DEPARTMENT OF NATURAL RESOURCES

Bureau of Land and Water Resources

Southport Mall

P.O. Box 10631

Jackson, Mississippi 39209

WATER WELL DRILLERS LOG

Pike  
J 2005

4-9  
date well completed

19 84 F. J. ...  
firm name

Pike  
county well located

LANDOWNER:  
Frank James  
R.R. 2, McComb, MS  
(mailing address)

description of formations encountered	from	to
<u>Red clay</u>	<u>0</u>	<u>20</u>
<u>Red gravel</u>	<u>20</u>	<u>80</u>
<u>Red sand</u>	<u>80</u>	<u>148</u>
<u>Coarse sand &amp; gravel</u>	<u>148</u>	<u>151</u>

WELL LOCATION:  
sec. 7 T. 2 N. R. 9 E  
S W  
9 miles E of McComb  
(distance) (direction) (nearest town)

WELL PURPOSE: Home  
(home, irrigation, municipal, industrial)

- WELL COMPLETION DATA:
- (1) diameter (inches) 4
  - (2) total depth (feet) 151
  - (3) static water level (feet) 105 below above top of ground.
  - (4) casing PVC, 148  
(material) (depth)  
4 if telescope see back.  
(size)
  - (5) screen 8, 143  
(length) (depth to top)  
4, PVC  
(size) (material)
  - (6) pump 1/2, 16  
(HP) (yield gpm)  
Gas  
(type power)
  - (7) electric log No  
(yes or no)  
(organization running log)
  - (8) how well bottom plugged Sand filter

DRILLERS REMARKS:


DEPT. OF NATURAL RESOURCES  
BUREAU OF LAND & WATER RESOURCES

APR 26 1984

RECEIVED

If well telescopes please  
sketch and show depths.

GROUND LEVEL

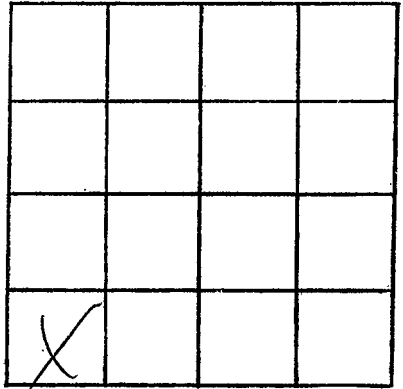

SECTION 2

Please indicate well location X.

ADDITIONAL INFORMATION

If more than one screen,  
show locations of each on sketch.