

MISSISSIPPI DEPARTMENT OF NATURAL RESOURCES

Bureau of Land and Water Resources

Southport Mall

P.O. Box 10631

Jackson, Mississippi 39209

WATER WELL DRILLERS LOG

PIKE
J
Adde

4-23
date well completed

1984 FITZGERALD WELL SERVICES
firm name

PIKE
county well located

LANDOWNER:
Joyce Allmond
RR 2, McComb, MS
(mailing address)

description of formations encountered	from	to
<u>Red clay</u>	<u>0</u>	<u>20</u>
<u>Red sand</u>	<u>20</u>	<u>110</u>
<u>Course sand + gravel</u>	<u>110</u>	<u>138</u>

WELL LOCATION:
sec. 8 T 2 N R 9 E
S W
8 miles E of McComb
(distance) (direction) (nearest town)

WELL PURPOSE: Home
(home, irrigation, municipal, industrial)

WELL COMPLETION DATA:

(1) diameter (inches) 4
(2) total depth (feet) 138
(3) static water level (feet) 95 below above top of ground.
(4) casing pvc, 130,
(material) (depth)
4 if telescope see back.
(size)
(5) screen 8, 130
(length) (depth to top)
4, pvc
(size) (material)
(6) pump 1/2, 10
(HP) (yield gpm)
elm
(type power)
(7) electric log no
(yes or no)
(organization running log)
(8) how well bottom plugged Shed

DEPT. OF NATURAL RESOURCES
BUREAU OF LAND & WATER RESOURCES


APR 26 1984

RECEIVED

DRILLERS REMARKS:

If well telescopes please sketch and show depths.

GROUND LEVEL

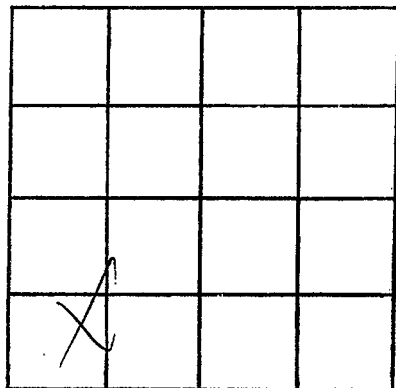

SECTION 8

Please indicate well location X.

ADDITIONAL INFORMATION

If more than one screen,
show locations of each on sketch.