

MISSISSIPPI DEPARTMENT OF NATURAL RESOURCES

Bureau of Land and Water Resources

Southport Mall

P.O. Box 10631

Jackson, Mississippi 39209

WATER WELL DRILLERS LOG

Pike
J
2068

1-9 1984
 date well completed

F. L. Goodall & Son
 firm name

Pike
 county well located


LANDOWNER:	description of formations encountered	from	to
<i>Mrs. Cullen Connally</i> <i>RR 2 M Corb, ms.</i> (mailing address)			
WELL LOCATION:			
sec. <i>3</i> T. <i>2</i> N. R. <i>9</i> E S W			
<i>9</i> miles <i>E</i> of <i>Corb</i> (distance) (direction) (nearest town)			
WELL PURPOSE:			
<i>Home</i> (home, irrigation, municipal, industrial)			
WELL COMPLETION DATA:			
(1) diameter (inches) <i>4</i>			
(2) total depth (feet) <i>140</i>			
(3) static water level (feet) <i>15</i> below top of ground.			
(4) casing <i>PVC</i> , <i>132</i> , (material) (depth) <i>4</i> if telescope see back. (size)			
(5) screen <i>8</i> , <i>132</i> (length) (depth to top) <i>4</i> , <i>PVC</i> (size) (material)			
(6) pump <i>1/2</i> , <i>10</i> (HP) (yield gpm) <i>Ele</i> (type power)			
(7) electric log <i>no</i> (yes or no) (organization running log)			
(8) how well bottom plugged <i>Sand fill</i>			

DRILLERS REMARKS:

DEPT. OF NATURAL RESOURCES
 BUREAU OF LAND & WATER RESOURCES
 MAR - 6 1984
 RECEIVED

If well telescopes please
sketch and show depths.

GROUND LEVEL

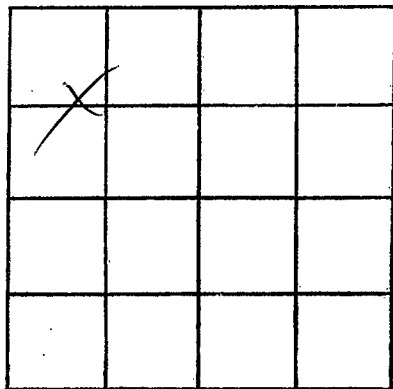

SECTION 3

Please indicate well location X.

ADDITIONAL INFORMATION

If more than one screen,
show locations of each on sketch.